


NOTE: BENCHMARK IS A 60d SPIKE UP 1.2 FEET IN THE SOUTH SIDE OF A 16" DIA. RED PINE



1220 CONTOUR LINE

27.2 SPOT ELEVATION, ADD 1200 TO GET MEAN SEA LEVEL DATUM 1929 ADJUSTMENT

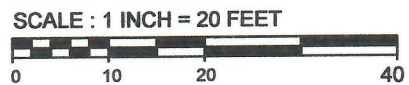

- FOUND IRON MONUMENT
- 3/8 INCH DIA. RE-ROD WITH RLS CAP NO. 17774 ESTABLISHED

MARVIN KOHOUT
 LICENSED LAND SURVEYOR
 PO BOX 384
 AITKIN, MN 56431-0384
 218-927-5452

I HEREBY CERTIFY THAT THIS SURVEY PLAN OR REPORT WAS PREPARED BY ME OR UNDER MY DIRECT SUPERVISION AND THAT I AM A DULY LICENSED LAND SURVEYOR UNDER THE LAWS OF THE STATE OF MINNESOTA.

Marvin R. Kohout