


# { Design Drawing }

Property Owner: Randy Carlson Date: 4/22/21 Designer's Initials: JB  
 Parcel ID. Number: 06-0-005100 Address: 18187 637th Ln. Jacobson MN 55752  
 one Inch = 40ft.

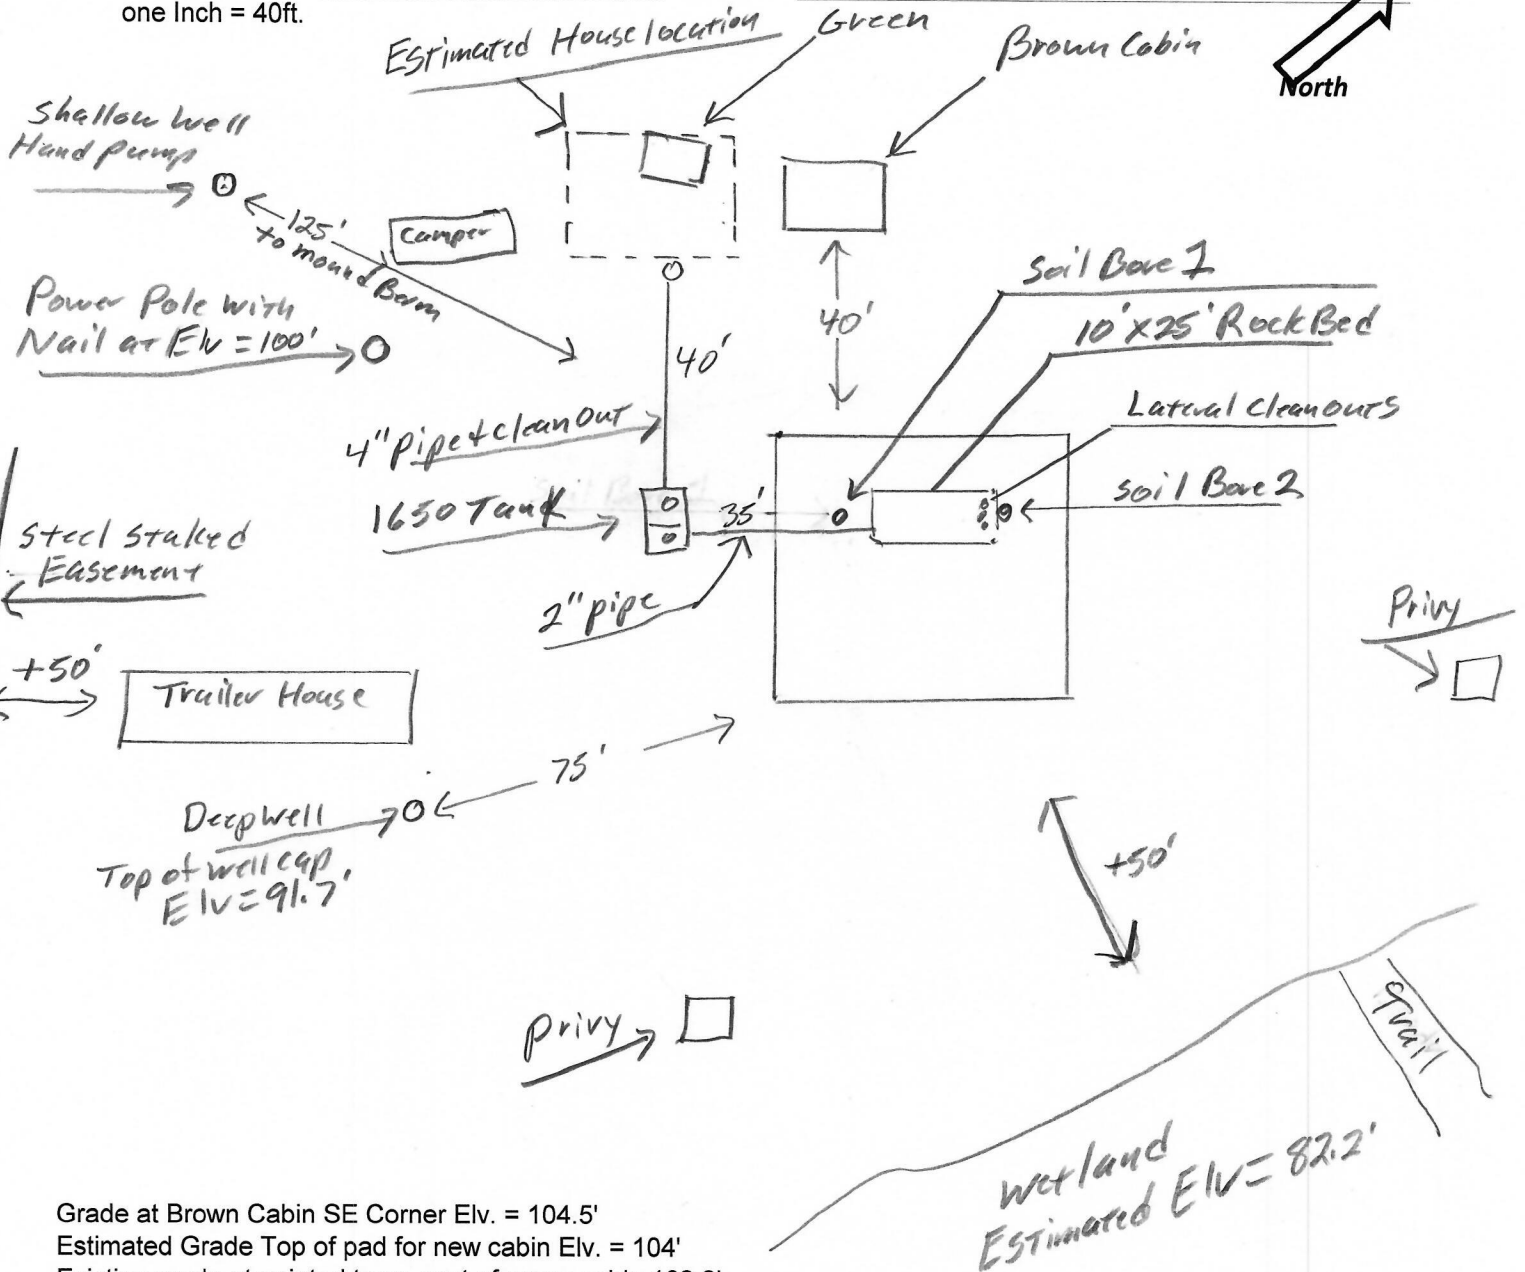

Grade at Brown Cabin SE Corner Elv. = 104.5'  
 Estimated Grade Top of pad for new cabin Elv. = 104'  
 Existing grade at painted trees east of green cabin 102.2'  
 Top of Deep well cap Elv. = 91.7'      Grade at Deep well Elv. = 89.6'

	Surface/ SHWT	Nail on Tele Ped = Bench Mark 100'		Existing Grade
Soil Bore 1	98' / 27"	Bench Mark	100'	Upslope Edge of Rockbed Elv. = 98.5'
Soil Bore 2	97.7' / 22"	Ground Elv. BM	100'	Bottom of Rockbed Elv. = 100'
Soil Bore 3		Ground Elv. Tank	98.5'	Top of Washed Sand Elv. = 100'
	Ground at	Proposed house	102'	Estimated Sewer pipe at Cabin Elv. = 100.5'

Please show all that apply ( Existing )

Please Draw to Scale with North to Top or Left Side of Page:

- Wells within 100ft. Of Drain field.
- Water lines within 10 ft. of Drain field.
- Drain field Areas:

- Disturbed/Compacted Areas
- Component Location
- OHW ordinary high water
- Lot Easements

- Access Route for Tank Maintenance
- Property Lines
- Structures
- Setbacks