





35

N.W. COR. GOVT. LOT 1

LOT 27

well

OWNER

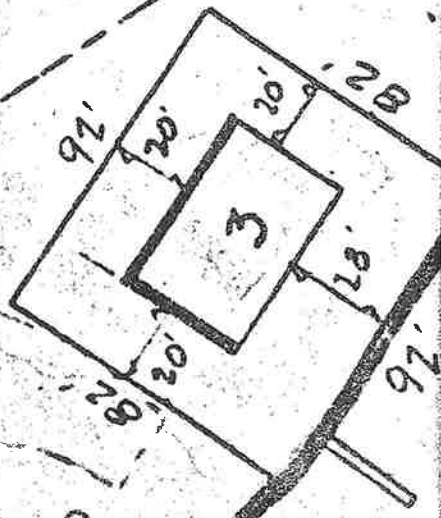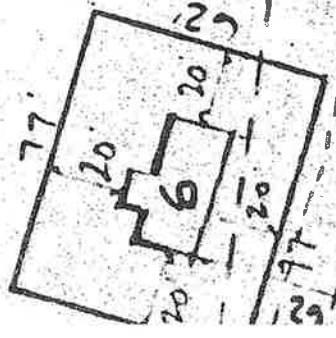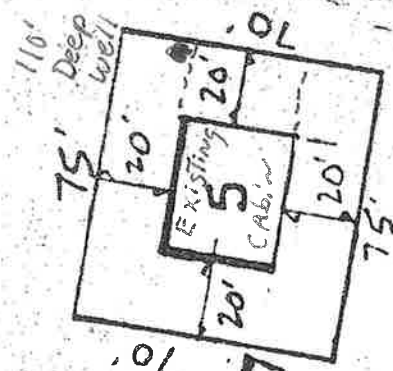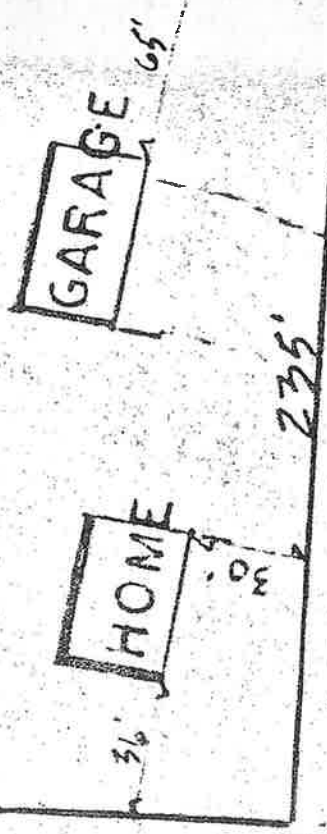

62.14' 309.27' 190' 160' 66' 66' N103.1114'

LAKE


265

HOME




27

well

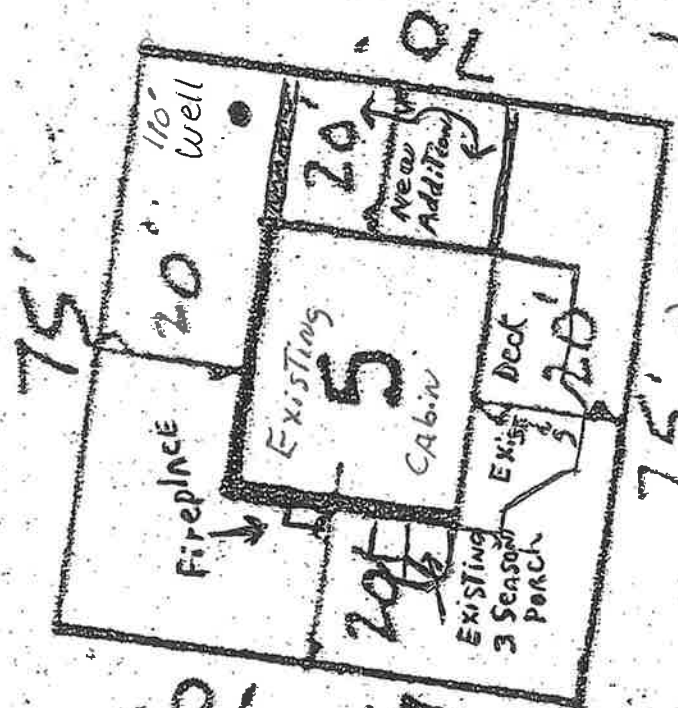

1) 3 SEASON PORCH
To be Removed
Replaced with Poured Wall (Cp)
Foundation - Storage Lower Part - Saw Room Main Level

2) Existing DECK To be Removed
Replaced with Smaller DECK within 20' of LOT LINE

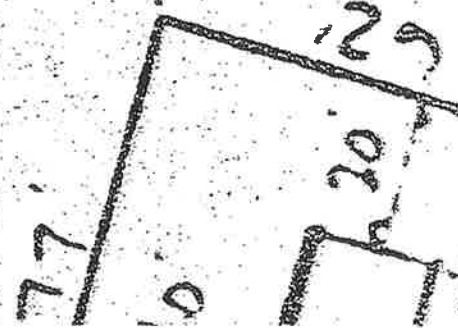

STREETS

STREETS

