

AITKIN COUNTY
CERTIFICATE OF INSTALLATION/~~NOTICE OF NONCOMPLIANCE~~

This certificate of installation/~~notice of noncompliance~~ has been issued this 26th day of July, 2021 to certify ~~compliance~~ noncompliance with Aitkin County's Subsurface Sewage Treatment System Ordinance.

The premises covered by this certificate are legally described as: _____
Lot 5 Blk 1 Siphers Scenic Shoreline

Section 20 Township 46 Range 26 Lake Lone
PERMIT NO. 46217 Owner Name Jeffrey & Connie Wetmore
Address 30097 Oak Ave. Aitkin, Mn 56431
Installer Name Fairchild Construction
Type of System Inspected Type I pressure bed
Parcel Number 24-1-098300

The certificate of installation/~~notice of noncompliance~~ was based on No 1 of the following:

- 1) Inspection of the installation or construction as in accordance with the above referenced permit and application design.
- 2) Review of as-built plans submitted in accordance with Subdivision 9.2 D of Aitkin County's Subsurface Sewage Treatment System Ordinance.

If the above permitted subsurface sewage treatment system is in noncompliance with Aitkin County's Subsurface Sewage Treatment System Ordinance, then the following shall serve as a Notice of Violation:

- 1) Statement of the findings of fact through inspections or investigations:

- 2) List of specific violations of Ordinance: _____

- 3) Requirements for correction or removal of violations: _____

- 4) Time schedule for compliance: _____

Failure to correct or remove the above violation(s) will result in this matter being turned over to the Aitkin County Attorney's Office for further legal action, which may result in revocation of licenses, fines and/or imprisonment.

INSPECTOR SIGNATURE _____

L. Parnock

**SUBSURFACE SEWAGE TREATMENT SYSTEM INSPECTION FORM
AITKIN COUNTY, MINNESOTA**

Township Nordland Date of Inspection 7-26-21 App. Number 2021-007703

Owner Jeffrey & Connie Wetmore Parcel Number 24-1-098300

Project Address 30097 Oak Ave Installer Fairchild Const.

City Aitkin Zip Code 56431

New Repair

SETBACKS:

Buildings to tank(s) 30'
Buildings to drainfield >100'
Well(s) 50' or 100' >50'
Lake/Creek/Wetland 75'

SEPTIC TANKS:

New Existing
Number of tanks installed 1 Sainderson Combo
Liquid capacity and type 1120 precast
Type of baffle Plastic
Inspection pipes -
Manholes size 2 @ 24" @ 25"
Manhole to grade Yes No

PUMPS:

New Existing
Tank capacity and type 530
Pump manufacturer & model # Zeller Bn152
Horsepower & GPM 30
Feet of head 23'
Gallons per cycle 65
Size of discharge line 2"
Type & location of alarm elec @ tank
Water meter -

DIST. or DROP BOX & TYPE


TRENCHES, BEDS, OR GRAVELLESS LEACHFIELD:

Trench/Bed depth 2'
Trench/Bed length 25'
Trench/Bed bottom width 16"
Trench spacing -
Drainfield rock below pipe 9"
Size of gravelless pipe -
Depth of backfill 1'
Absorption area: square feet 400
lineal feet -

MOUNDS:

Percent slope -
Upslope sand width -
Downslope sand width -
Sideslope sand width -
Drainfield rock below pipe -
Depth of sand below rock -
Perforation size & spacing 1/4 x 3
Pipe size & spacing 1 1/4 x 3
Dimensions of rock bed -
Dimensions of sand base -
Final cover -

DRAWING OF SYSTEM: (include soils)

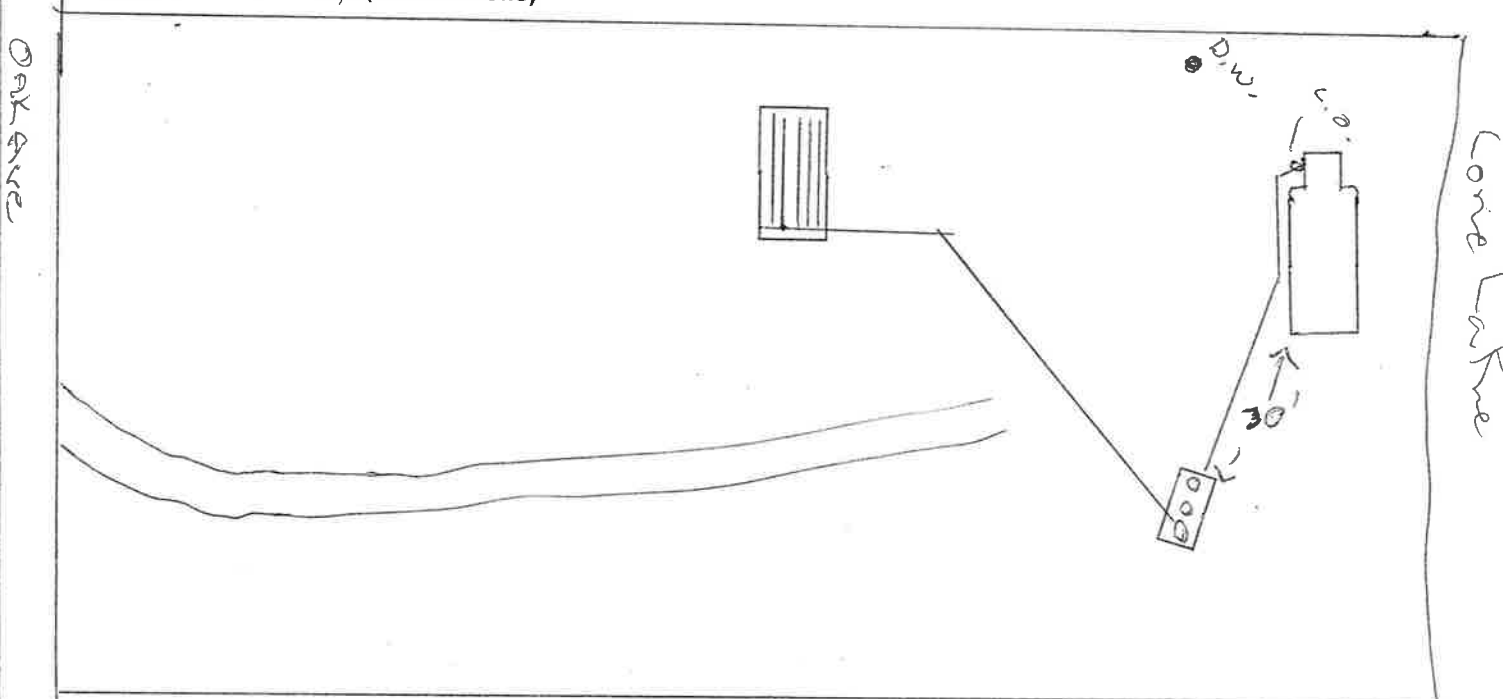

Inspector's Comments: _____

Inspector's Signature X-124 Installer's Signature _____