

Attention: KIM  
Permits for 3 sheds


- (2) 18x20
- (1) 10x26

Brian & Kathy Baldwin  
62221 Great River Road  
Jacobson, MN 55752

218-752-1193

Sheds

Great River Rd. (cont'd)

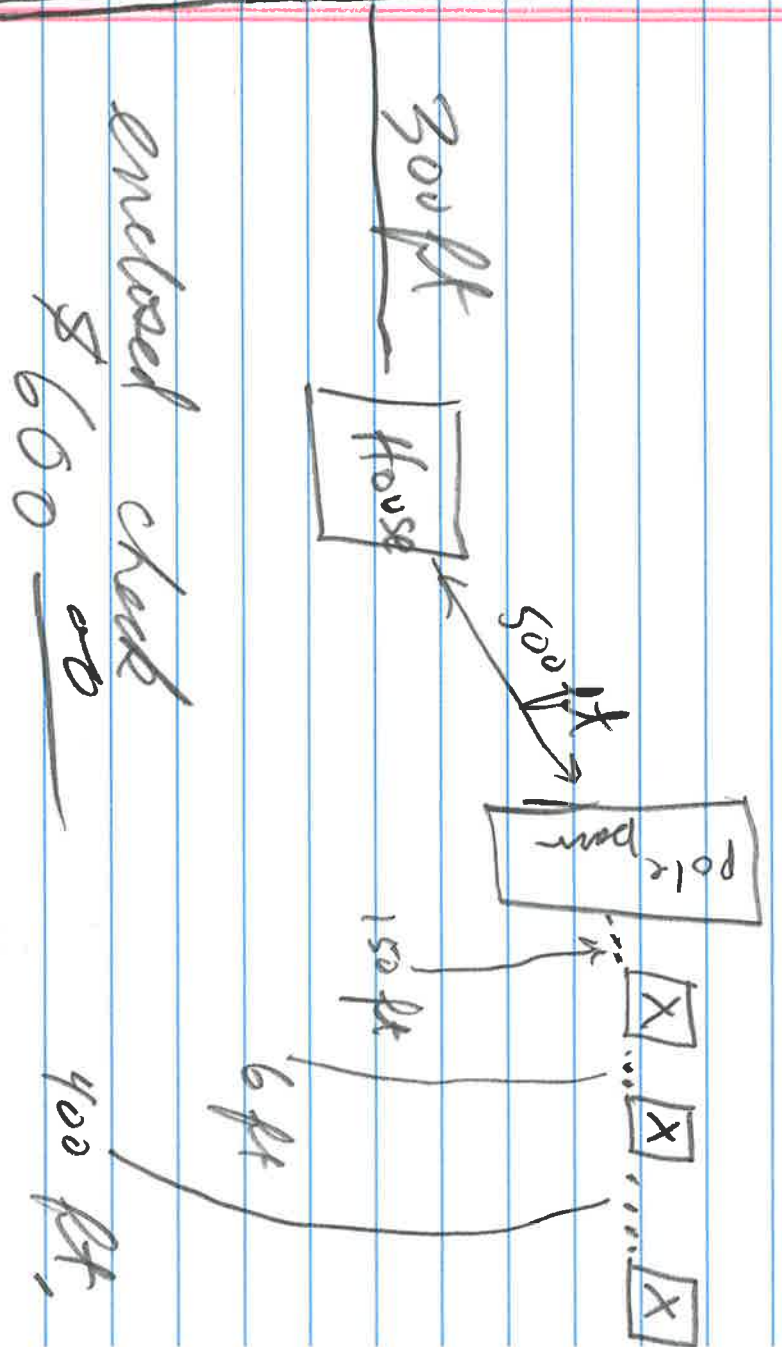

enclosed check  
\$600

400 ft.