

**AITKIN COUNTY**  
**CERTIFICATE OF INSTALLATION/~~NOTICE OF NONCOMPLIANCE~~**

This certificate of installation/~~notice of noncompliance~~ has been issued this 1st day of August, 2022 to certify compliance/~~noncompliance~~ with Aitkin County's Subsurface Sewage Treatment System Ordinance.

The premises covered by this certificate are legally described as: PT OF LOT 2 IN DOC 464072 LESS PTS IN DOCS 465334 & 470988 & 471486 (TRACT A)

Section 28 Township 46 Range 27 Lake Farm Island  
PERMIT NO. 46589 Owner Name Prohaski Hideaway LLC  
Address 29777 Pioneer Ave Aitkin, Mn 56431  
Installer Name Borden Excavating  
Type of System Inspected 3 Bdrm Type III Mound  
Parcel Number 07-1-079500 07-1-079503

The certificate of installation/~~notice of noncompliance~~ was based on No 1 of the following:

- 1) Inspection of the installation or construction as in accordance with the above referenced permit and application design.
  
- 2) Review of as-built plans submitted in accordance with Subdivision 9.2 D of Aitkin County's Subsurface Sewage Treatment System Ordinance.

If the above permitted subsurface sewage treatment system is in noncompliance with Aitkin County's Subsurface Sewage Treatment System Ordinance, then the following shall serve as a Notice of Violation:

- 1) Statement of the findings of fact through inspections or investigations:

\_\_\_\_\_

2) List of specific violations of Ordinance: \_\_\_\_\_

\_\_\_\_\_

3) Requirements for correction or removal of violations: \_\_\_\_\_

\_\_\_\_\_

4) Time schedule for compliance: \_\_\_\_\_

Failure to correct or remove the above violation(s) will result in this matter being turned over to the Aitkin County Attorney's Office for further legal action, which may result in revocation of licenses, fines and/or imprisonment.

INSPECTOR SIGNATURE



**SUBSURFACE SEWAGE TREATMENT SYSTEM INSPECTION FORM**  
**AITKIN COUNTY, MINNESOTA**

Township Farm Island Date of Inspection 8-1-22 Final App. Number 2021-008172  
07-1-079503 Date of Inspection 6-8-23 Initial  
 Owner Prohaski Hideaway LLC Parcel Number 07-1-079503-07-1-079503  
 Project Address 29777 Pioneer Ave Installer Borden Excavating  
 City Aitkin Zip Code 56431

New  Repair

**SETBACKS:**

Buildings to tank(s) 30  
 Buildings to drainfield 68  
 Well(s) 50' or 100' No well  
 Lake/Creek/Wetland \_\_\_\_\_

**SEPTIC TANKS:** New  Existing \_\_\_\_\_  
 Number of tanks installed 2 Sather  
 Liquid capacity and type 2450 2 Comp Plastic  
 Type of baffle Plastic  
 Inspection pipes \_\_\_\_\_  
 Manholes size 3 @ 24"  
 Manhole to grade Yes  No \_\_\_\_\_

**PUMPS:** New  Existing \_\_\_\_\_  
 Tank capacity and type 1500 Procast  
 Pump manufacturer & model # Zellerbach 152  
 Horsepower & GPM 1/2 hp 42 gpm  
 Feet of head 33  
 Gallons per cycle 110  
 Size of discharge line 2"  
 Type & location of alarm Elec at Tank  
 Water meter \_\_\_\_\_

DIST. or DROP BOX & TYPE \_\_\_\_\_


**TRENCHES, BEDS, OR GRAVELLESS LEACHFIELD:**

Trench/Bed depth \_\_\_\_\_  
 Trench/Bed length \_\_\_\_\_  
 Trench/Bed bottom width \_\_\_\_\_  
 Trench spacing \_\_\_\_\_  
 Drainfield rock below pipe \_\_\_\_\_  
 Size of gravelless pipe \_\_\_\_\_  
 Depth of backfill \_\_\_\_\_  
 Absorption area: square feet \_\_\_\_\_  
 lineal feet \_\_\_\_\_

**MOUNDS:**

Percent slope \_\_\_\_\_  
 Upslope sand width 12'  
 Downslope sand width 18'  
 Sideslope sand width 12'  
 Drainfield rock below pipe 9"  
 Depth of sand below rock 3'  
 Perforation size & spacing 1/2" x 3'  
 Pipe size & spacing 2" x 3'  
 Dimensions of rock bed 10 x 25  
 Dimensions of sand base 40 x 105  
 Final cover 18" Top 12" Sides

**DRAWING OF SYSTEM: (include soils)**

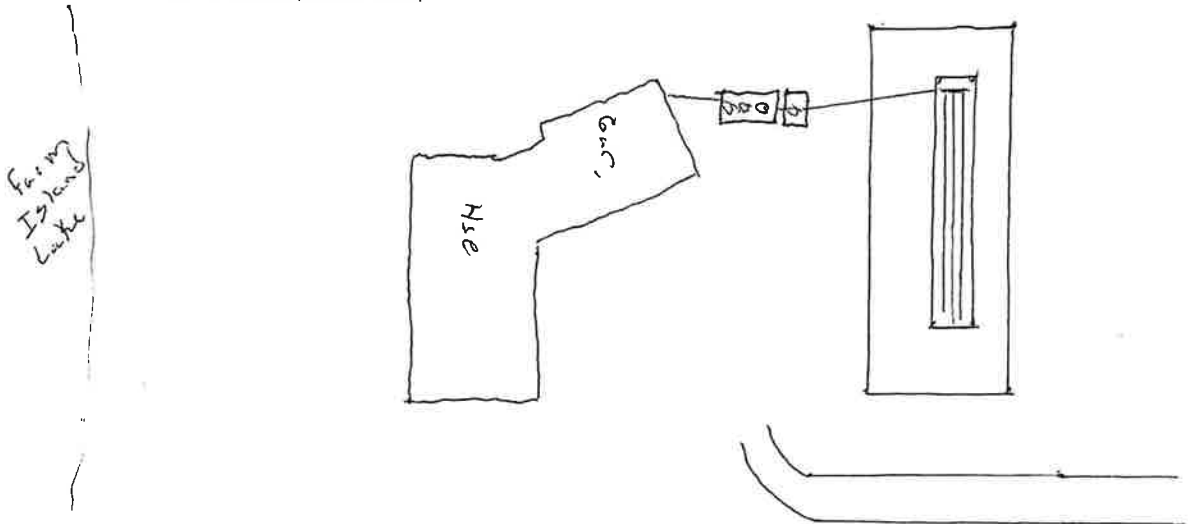

Inspector's Comments: \_\_\_\_\_

Inspector's Signature [Signature] Installer's Signature [Signature] 1792