AITKIN COUNTY	
CERTIFICATE OF INSTALLATION/NOTICE OF NONCOMPLIANCE	


This certificate of installation/notice of noncompliance has been issued this
day of, 20 to certify compliance\ <del>noncompliance</del> with Aitkin County's Subsurface Sewage Treatment System Ordinance.
Aitkin County's Subsurface Sewage Treatment System Ordinance.
The premises covered by this certificate are legally described as:
Section Township Range Lake   PERMIT NO Owner Name
PERMIT NO. Owner Name
Address
Installer Name
Installer Name Type of System Inspected
Parcel Number
The certificate of installation/ <del>notice of noncompliance</del> was based on No of the following:
1) Inspection of the installation or construction as in accordance with the above
referenced permit and application design.
referenced permit and application design.
2) Review of as built plans submitted in accordance with Subdivision 0.2 D of
2) Review of as-built plans submitted in accordance with Subdivision 9.2 D of
Aitkin County's Subsurface Sewage Treatment System Ordinance.
If the choice normitted subsurface courses treatment eveters is in non-coursilence with
If the above permitted subsurface sewage treatment system is in noncompliance with
Aitkin County's Subsurface Sewage Treatment System Ordinance, then the following
shall serve as a Notice of Violation:
1) Statement of the findings of fact through inspections or investigations:
2) List of specific violations of Ordinance:
<ol><li>Requirements for correction or removal of violations:</li></ol>
4) Time schedule for compliance:
Failure to correct or remove the above violation(s) will result in this matter being
turned over to the Aitkin County Attorney's Office for further legal action, which may
result in revocation of licenses or registrations, fines and/or imprisonment.
INSPECTOR SIGNATURE

## SUBSURFACE SEWAGE TREATMENT SYSTEM INSPECTION FORM **AITKIN COUNTY, MINNESOTA**

Township Farm Island Date of Inspection	10/5/2021 App. Number 46492
	Parcel Number <u>07-1-100200</u>
Project Address 29744 Partridge Ave.	Installer Tom Antonsen
City Aitkin Zip Code 564	TI 3BR PB
New 📝 Repair	DIST. or DROP BOX & TYPE Pressure Bed
SETBACKS:	TRENCHES, BEDS, OR GRAVELLESS LEACHFIELD:
Buildings to tank(s)	Trench/Bed depth_24"
Buildings to drainfield	Trench/Bed length
Well(s) 50' or 100' <u>561:88' to tank</u>	Trench/Bed bottom width $15'$
Lake/Creek/Wetland Farm Island: 100'+ totank	French spacing (4) 1,5" laterals
	Drainfield rock below pipe_9 ″
SEPTIC TANKS: New Existing	Size of gravelless pipe
Number of tanks installed (1) Sa ther 1500 combo	Depth of backfill <u>20"</u>
Liquid capacity and type 1000 part combo	Absorption area: square feet $572.5f$
Type of baffle Plastic	lineal feet
Inspection pipes	MOUNDS:
Manholes size24"	Percent slope
Manhole to grade Yes 🖌 No	Upslope sand width
	Downslope sand width
PUMPS: New 🗹 Existing	Sideslope sand width
Tank capacity and type 500 part combo	Drainfield rock below pipe
Pump manufacturer & model # <u>Zoeller</u> BNI52	Depth of sand below rock
Horsepower & GPM <u>0,4 I+P</u> <u>39GPM</u>	Perforation size & spacing <u>D_25"/36"5p</u>
Feet of head <u>19</u>	Pipe size & spacing <u>/ \$ ″/40″ sp.</u>
Gallons per cycle	Dimensions of rock bed
Size of discharge line <u>1,5"</u>	Dimensions of sand base
Type & location of alarm <u>Ekc. on tenk</u>	Final cover
Water meter	soil - P
DRAWING OF SYSTEM: (include soils)	501 4 0-5" 104R3/2 SL 5-10% Cf But 5-29" 104R4/3 LS 20-25% Cf C 29-70" 104R5/4+6/4 5 10-15% Cf

Inspector's Comments: \_\_\_\_

Rev:1/13

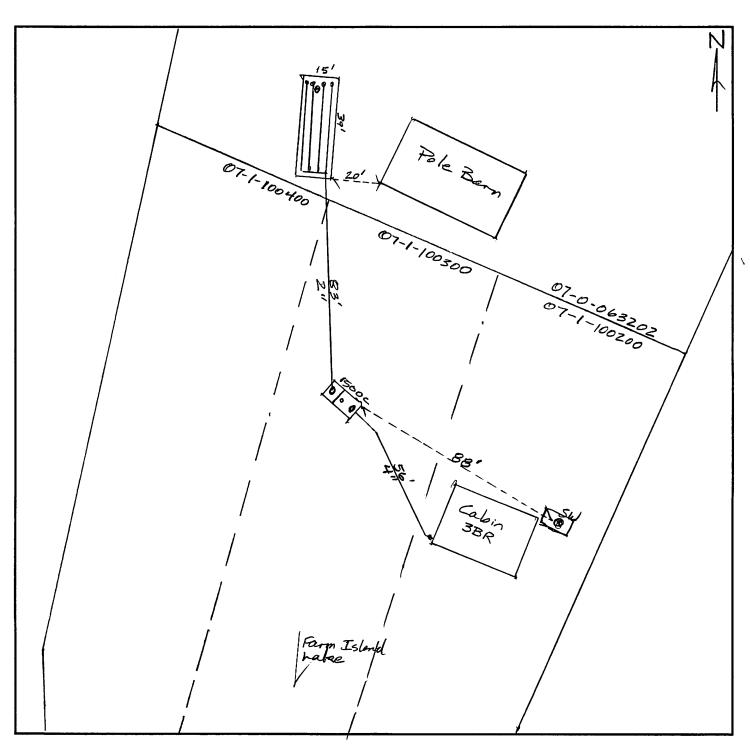

Soils				
A	0-5"	10 YR 3/2 10 YR 4/3 10 YR 5/4 10 YR 5/4	SL	5-1070 cf
BW	5-29"	104R 4/3	LS	5-10%-cf 20-25%-cf 10-15%-cf
C	29-70"+	104R5/4	C5	10-15% of
		104R6/4		

Notes			
L	 		







