

AITKIN COUNTY
CERTIFICATE OF INSTALLATION/~~NOTICE OF NONCOMPLIANCE~~

This certificate of installation/~~notice of noncompliance~~ has been issued this 3rd day of December, 2021 to certify ~~compliance~~noncompliance with Aitkin County's Subsurface Sewage Treatment System Ordinance.

The premises covered by this certificate are legally described as: Part of Govt. lot 4 (Tract 1)

Section 19 Township 469 Range 23 Lake Sandy River Lake
PERMIT NO. 46632 Owner Name Scott Brazinsky Etal
Address 48413 216th Pl McGregor, Mn 55760
Installer Name B&T Sales
Type of System Inspected Type I tank replacement
Parcel Number 29-0-040302

The certificate of installation/~~notice of noncompliance~~ was based on No 1 of the following:

- 1) Inspection of the installation or construction as in accordance with the above referenced permit and application design.
- 2) Review of as-built plans submitted in accordance with Subdivision 9.2 D of Aitkin County's Subsurface Sewage Treatment System Ordinance.

If the above permitted subsurface sewage treatment system is in noncompliance with Aitkin County's Subsurface Sewage Treatment System Ordinance, then the following shall serve as a Notice of Violation:

- 1) Statement of the findings of fact through inspections or investigations:

2) List of specific violations of Ordinance: _____

3) Requirements for correction or removal of violations: _____

4) Time schedule for compliance: _____

Failure to correct or remove the above violation(s) will result in this matter being turned over to the Aitkin County Attorney's Office for further legal action, which may result in revocation of licenses, fines and/or imprisonment.

INSPECTOR SIGNATURE



**SUBSURFACE SEWAGE TREATMENT SYSTEM INSPECTION FORM
AITKIN COUNTY, MINNESOTA**

Township Shamrock Date of Inspection 11-29-21 App. Number 2021-008388

Owner Scott Brazinsky Etal Parcel Number 29-0-040302

Project Address 48413 216th Pl. Installer BT Sales

City McGregor Zip Code 55760

New Repair Type I tank replacement DIST. or DROP BOX & TYPE _____

SETBACKS: TRENCHES, BEDS, OR GRAVELLESS LEACHFIELD:

Buildings to tank(s) 24' Trench/Bed depth _____

Buildings to drainfield >150 existing Trench/Bed length _____

Well(s) 50' or 100' >50' Trench/Bed bottom width _____

Lake/Creek/Wetland >100' Trench spacing _____

SEPTIC TANKS: New Existing _____ Drainfield rock below pipe _____

Number of tanks installed 1 Jacobson Combo Size of gravelless pipe _____

Liquid capacity and type 113A precast Depth of backfill _____

Type of baffle Plastic Absorption area: square feet _____

Inspection pipes _____ lineal feet _____

Manholes size 2 @ 24" 1 @ 20" MOUNDS: _____

Manhole to grade Yes No _____ Percent slope _____

PUMPS: New Existing _____ Upslope sand width _____

Tank capacity and type 530' Downslope sand width _____

Pump manufacturer & model # Liberty 283 Sideslope sand width _____

Horsepower & GPM .5 29 Drainfield rock below pipe _____

Feet of head 57' Depth of sand below rock _____


Gallons per cycle 113 / 120 w/drainback Perforation size & spacing _____

Size of discharge line 2" Pipe size & spacing _____

Type & location of alarm SLU in residence Dimensions of rock bed _____

Water meter _____ Dimensions of sand base _____

DRAWING OF SYSTEM: (include soils)

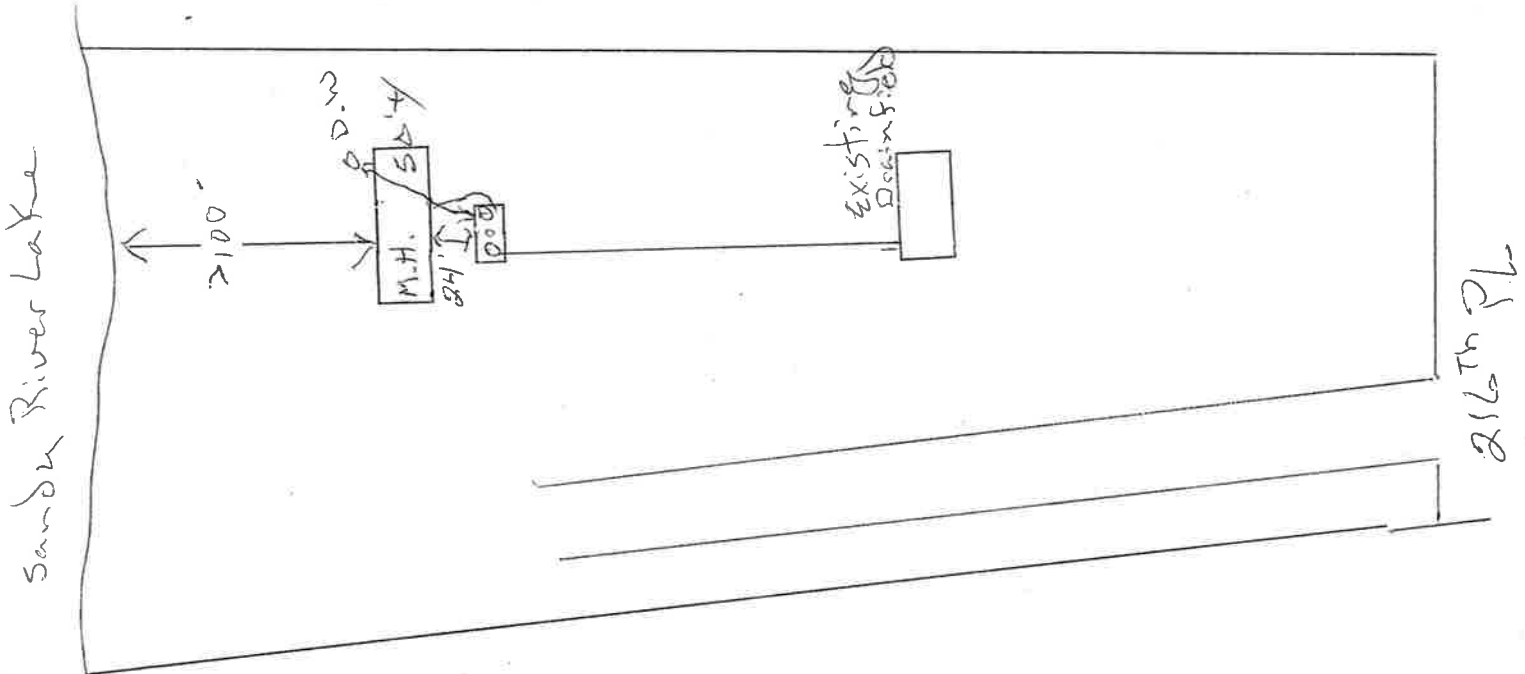

Inspector's Comments: _____

Inspector's Signature _____ Installer's Signature _____