

AITKIN COUNTY
CERTIFICATE OF INSTALLATION/~~NOTICE OF NONCOMPLIANCE~~

This certificate of installation/~~notice of noncompliance~~ has been issued this 18th day of August, 2022 to certify compliance/~~noncompliance~~ with Aitkin County's Subsurface Sewage Treatment System Ordinance.

The premises covered by this certificate are legally described as: _____
NE OF NE

Section 31 Township 47 Range 25 Lake _____
PERMIT NO. 46653 Owner Name Diana Barr
Address 35001 330th Ave Aitkin, Mn 56431
Installer Name Liljenquist Sewer
Type of System Inspected 2 Bdrm Type III Mound
Parcel Number 15-0-052500

The certificate of installation/~~notice of noncompliance~~ was based on No 1 of the following:

- 1) Inspection of the installation or construction as in accordance with the above referenced permit and application design.

- 2) Review of as-built plans submitted in accordance with Subdivision 9.2 D of Aitkin County's Subsurface Sewage Treatment System Ordinance.

If the above permitted subsurface sewage treatment system is in noncompliance with Aitkin County's Subsurface Sewage Treatment System Ordinance, then the following shall serve as a Notice of Violation:

- 1) Statement of the findings of fact through inspections or investigations:

- 2) List of specific violations of Ordinance: _____

- 3) Requirements for correction or removal of violations: _____

- 4) Time schedule for compliance: _____

Failure to correct or remove the above violation(s) will result in this matter being turned over to the Aitkin County Attorney's Office for further legal action, which may result in revocation of licenses, fines and/or imprisonment.

INSPECTOR SIGNATURE _____

L. - - Purock

**SUBSURFACE SEWAGE TREATMENT SYSTEM INSPECTION FORM
AITKIN COUNTY, MINNESOTA**

Township Kimberly Date of Inspection 8-18-22 Final App. Number 2021-008395
 Owner Diana Barr Parcel Number 15-0-052500
 Project Address 35001 330th Ave Installer Liljengois Sewer
 City Aitkin Zip Code 56431

New Repair

SETBACKS:

Buildings to tank(s) 29'
 Buildings to drainfield 45'
 Well(s) 50' or 100' No well yet
 Lake/Creek/Wetland _____

SEPTIC TANKS: New Existing

Number of tanks installed 1 Jacobson 1650
 Liquid capacity and type 1125 precast
 Type of baffle Plastic
 Inspection pipes _____
 Manholes size 20" 24" 10" 20"
 Manhole to grade Yes No

PUMPS: New Existing

Tank capacity and type 530 precast
 Pump manufacturer & model # Liberty 283
 Horsepower & GPM 0.5 22 gpm
 Feet of head 18
 Gallons per cycle 75
 Size of discharge line 2"
 Type & location of alarm elec @ Tank
 Water meter _____

DIST. or DROP BOX & TYPE _____


TRENCHES, BEDS, OR GRAVELLESS LEACHFIELD:

Trench/Bed depth _____
 Trench/Bed length _____
 Trench/Bed bottom width _____
 Trench spacing _____
 Drainfield rock below pipe _____
 Size of gravelless pipe _____
 Depth of backfill _____
 Absorption area: square feet _____
 lineal feet _____

MOUNDS:

Percent slope 0
 Upslope sand width 20'
 Downslope sand width 20'
 Sideslope sand width 20'
 Drainfield rock below pipe 9"
 Depth of sand below rock 3'
 Perforation size & spacing 1/4" x 3'
 Pipe size & spacing 1 1/2" x 3'
 Dimensions of rock bed 16 x 38
 Dimensions of sand base 50 x 78
 Final cover 16" Top 12" sides

DRAWING OF SYSTEM: (include soils)

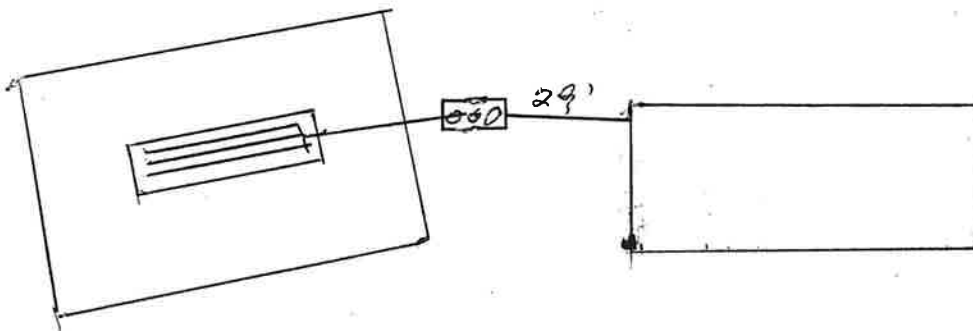

Inspector's Comments: _____

Inspector's Signature [Signature] Installer's Signature _____