



# CERTIFICATE OF SURVEY

OF PART OF LOT 6 BLOCK 2  
WONDERLAND POINT  
AITKIN COUNTY, MINNESOTA

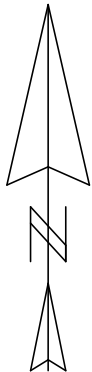

SCALE : 1 INCH = 50 FEET

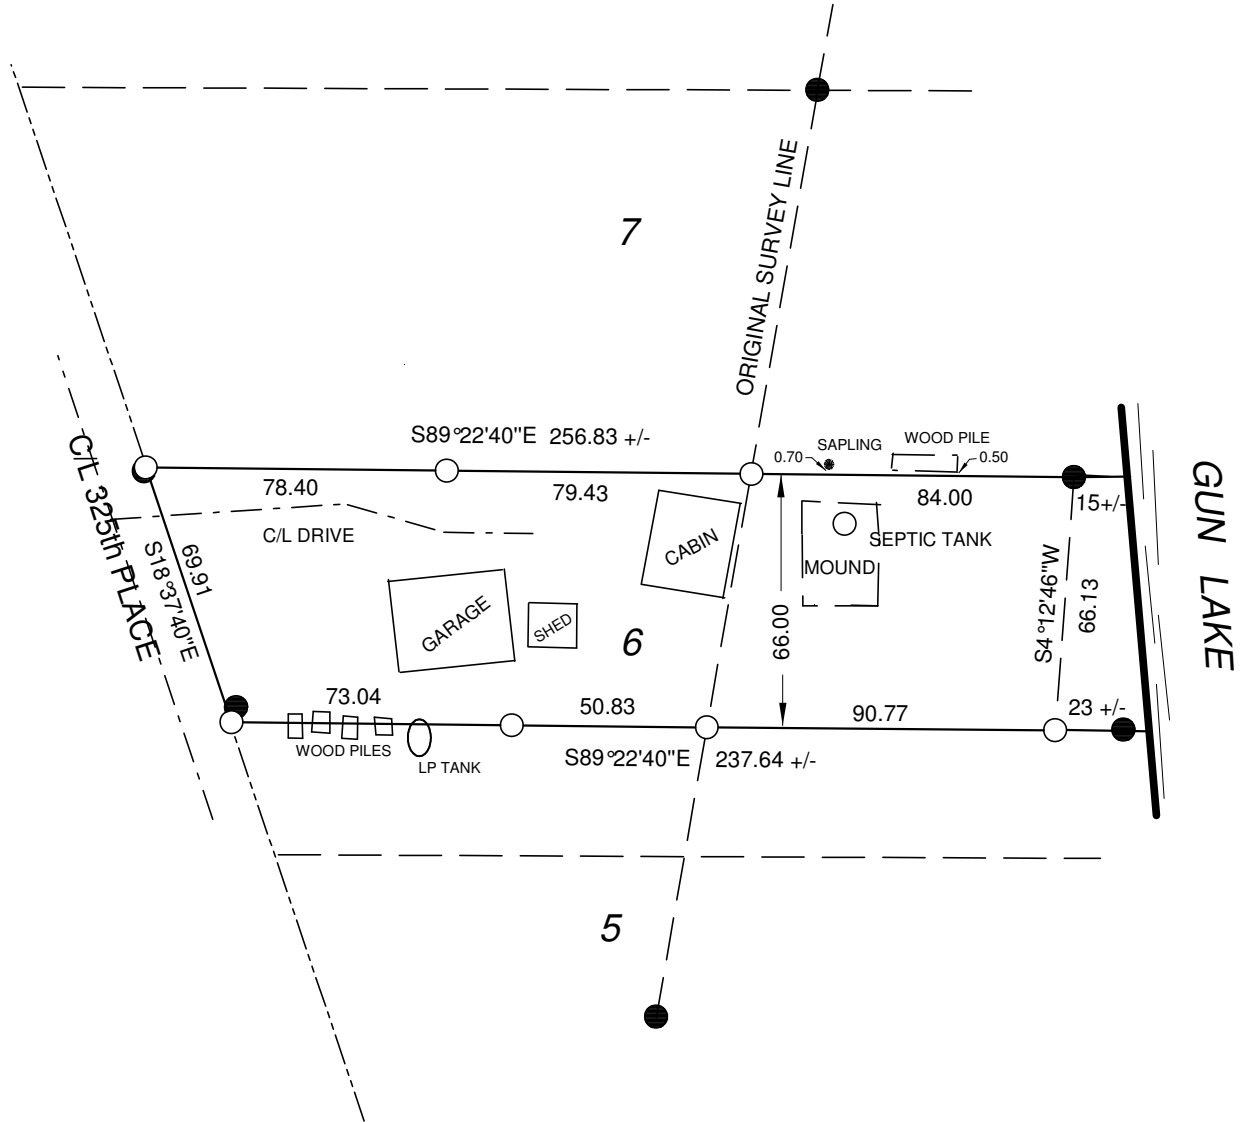

- FOUND IRON MONUMENT
- 3/8 INCH DIA. RE-ROD WITH RLS  
CAP NO. 17774 ESTABLISHED

BEARING DATUM IS AITKIN COUNTY  
COORDINATE SYSTEM

MARVIN KOHOUT  
LICENSED LAND SURVEYOR  
PO BOX 384  
AITKIN, MN 56431-0384  
218-927-5452

I HEREBY CERTIFY THAT THIS SURVEY PLAN OR REPORT WAS  
PREPARED BY ME OR UNDER MY DIRECT SUPERVISION AND  
THAT I AM A DULY LICENSED LAND SURVEYOR UNDER THE  
LAWS OF THE STATE OF MINNESOTA.

MARVIN R. KOHOUT

DATE 16 APRIL 2015 LIC. NO. 17774