
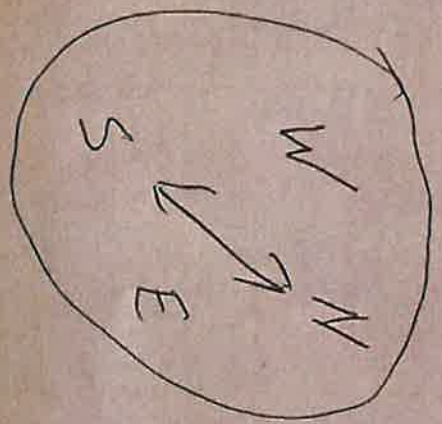


151'

AMENDED  
6/2/22

0' well

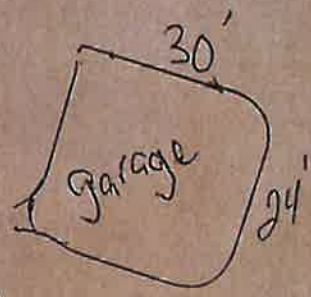

lot line

390'

225'

75'

26'

30'  
26'

32'

Proposed

105'

305'

Driveway

48'

179'

315<sup>th</sup> LN

