
Home Owner: TIM MCNEIC Billing Address: 66 331 182 PLAC Directions: Home Phone:	RONALD MYERS DOING BUSINESS AS EXTRACTOR 32721 NV. 19 10 10 10 10 10 10 10 10 10 10 10 10 10		
Cell Phone: 612-327-3954 Work Phone: Date of Pumping: Next Recommended Pump Date: Legal Dis. Or Pin # Septic Installer Name, Phone #, Date of Installation: CRAIG MC MRIC	Treatment Location: WWTP Site 1 2 3 4 5 Was the Septic Tank Pumped Through the Maintenance hole (7080 0175)?		
# of Bedrooms: Type of Septic System (Circle One) Pressure Bed Trench Mound Other: Septic Tank Location Reference to Non-moveable Object:	If no maintenance hole exists on a sewage tank, the owner or the owner's agent shall install maintenance holes in sewage tanks in accordance with part 7080.0130, subpart 2, item M, subitem (1), to allow for maintenance to take place through the maintenance hole. If the owner or owner's agent refuses to allow the removal through a maintenance hole, the licensed pumper must obtain a signed statement from the owner or owner's agent that the owner or agent was informed of correct removal procedures and the reason for refusal.		
Type of Q	Reason (Circle One):		
Type of Septic Tank (Circle One) Block Precast	No maintenance hole		
Block Precast Plastic Steel Fiberglass	Home owner refused access to manhole		
· Citalie,			
Is the Septic Tank Watertight and in Good Structural Condition?	No manhole		
Tank Baffle:	Other: VANDUSE (CONTROLLE)		
Depth to Riser: SURFACTE	UNION DUST 663310		
Yes No.	HOTMAIL, COM		
Cleaned: Yes			
rest Pump and Alarm Good	Pumping		
of On Demand	Materials		
Pipe Settling or Movement:			
BILL END	Line Cleaning		
DESIGN FOR HALD	Thawing		
TONK HOLDING			
GAL	Mileage		
TO TO DO	Disposal Fee		
k 400	Holding tank		
	Septage		
rivers name:	Other		
amoon a co	D1916N 400		
omeowner's Signature	TOTAL		

FIELD EVALUATION SHEET

PRELIMINARY EVALUATION DA	TE5/14/22 F	ELD EVALUATI	ION DATE EL	4122			
		177		/ -			
ADDRESS: 66331 182 P LEGAL DESCRIPTION:	LACE CITY, STATI	EZIP: TACA	MGDA MAL	567			
PIN# A2 ~ (A~ 03 (CA)	18000	The state of the s	LI JOSO POIN	23/32			
PIN# 02 - (0-03980/): FIRE# LAKE/RIVER 1/	-P SEC 22 T 52	R 23 TWP NA	ME BALC &	LUFF			
	ANDUCK	LAKE CLA		HWL FT.			
DESCRIPTION OF S	OIL TREATMENT AR	EAG					
· AREA	¥1 AREA#						
DISTURBED AREAS YES	an appear as as	4 4 Nou 0 C	ERENCE BM ELE	VF			
COMPACTED AREAS YES	415	NO NEI	ERENCE BM DE	SCRIPTION_			
FLOODING YES_		vo -					
RUN ON POTENTIAL YES	0.100	10		-			
SLOPE %	_ X	-					
DIRECTION OF SLOPE		*** C					
LANDSCAPE POSITION VEGETATION TYPES							
TEGETATION TYPES							
DEPTH TO STANDING WATER O	R MOTTLED SOIL: B	ORING# 1	_, 1A, 2	7 A			
				,&R			
BOTTOM ELEVATION-FIRST TRENCH OR BOTTOM OF ROCK BED: #1 FT., #2 FT.							
SOIL SIZING FACTOR: SITE #1_	9 4	TE #2					
CONSTRUCTION RELATED ISSUES	HACDIAC.	TIME	C 0 0 0 000	_ ,			
CONSTRUCTION RELATED ISSUES	HOUNG	IANTC	FOR DU	T HOUSE			
607		٨					
SILEE	VALUATOR SIGNATUR	E: Van V	m				
SITE EVALUATOR NAME: RON	MYERS) (((-)	60 02 70			
LUG REVIEW		ierebhoi	NE# 118-1	31-1213			
TO ME AIT AA		DATE					
Comments:				-			
-			-				
AA!							
JACOBSIN	BORING LOGS ON	REVERSE SIDE	5				
-460031W	511	10-	• • • •				
	520 1	. C. T	カル R				

Form des 2/20/98

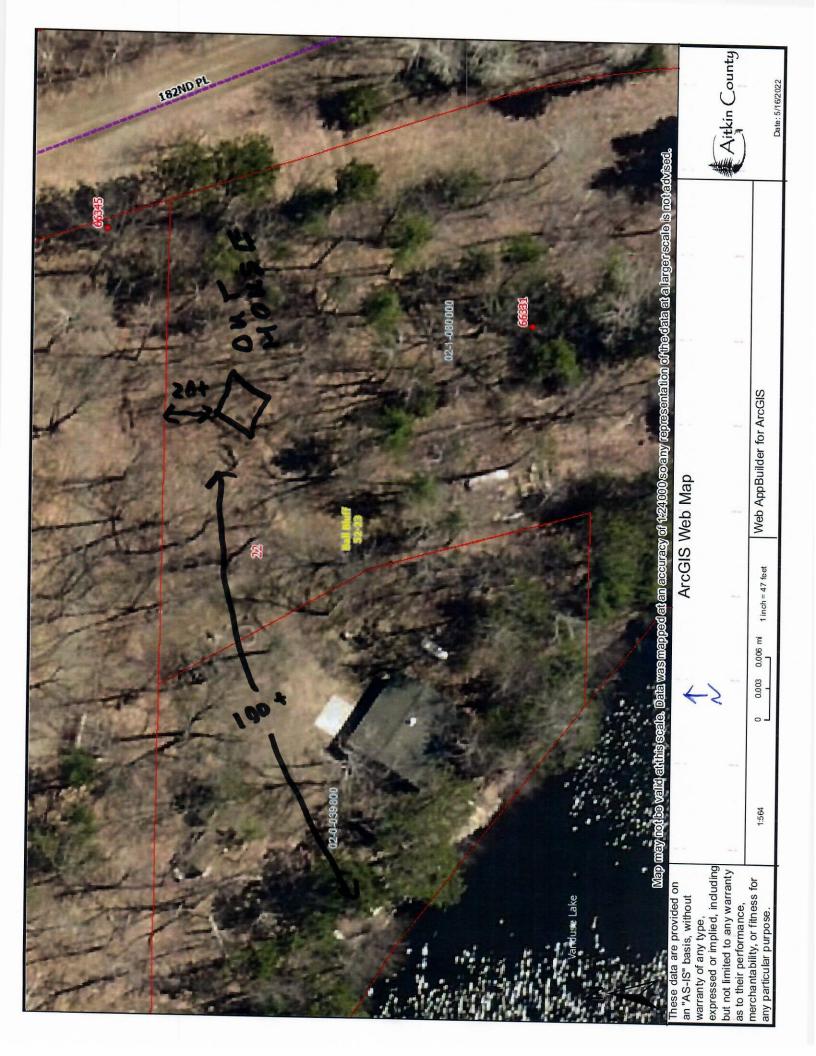

	INDIVIDUAL \$1 MONITOR	EWAGE TREATMENT SYSTEM AND DISPOSAL CONTRACT HOLDING TANK	OUT HOUSIE	
General Provisions A. Purpose The purpose of this contract is to define the obligations of the Property Owner and a Licensed Pumper with respect to compliance of Minnesota Pollution Control Agency - Chapter 7080 Rules pertaining to SSTS—specifically 7080.0172, Subp. 3. HOLDING TANKS				
approval for the insubject to the requirement of the suitable clear have an alarm deviated and the sewage. The Licensed Purcharge, to an alarm the schedule for	istaliation of a non- tirements set forth is eanout pipe, be 150 vice to minimize cholish and maintain a ne contract is to be imper shall guarante impropriate facility of the maintenance shall	ance of sewage overflow. The pro- a contract with a licensed pumper maintained until the holding tank the the removal of the tank contents established for that purpose. be as follows: A S A d dates of payments) shall be as for	cluding that the holding tank cessible area for maintenance and operty owner shall be required to for proper disposal and treatment is properly abandoned. Sprior to overflow or any FREDIAD Collows: \$\frac{1}{2} \frac{75}{3} \text{Jumping}\$	
C. Contract Agreem Property Owner		TIM MONTIC 66331 182 PLA JACOBSON MN	35112	
Pumper - Name	/Address/License #	: RON MYMRS DBA: RON-TEX 32731 WOOD LAND PK RD, G.R. #697		
The above parties hereby agree to carry out all their obligations beginning this date <u>5/16/22</u> and to be continuous, unless terminated by either party, with or without cause, upon 60 days written notice. [Notice shall also be given to the County Zoning Office.]				
D. Signatures			•	
	muni	Property Owner 5/06/22 Licensed Pumper	(218) 327-9273	

٠,