

**SUBSURFACE SEWAGE TREATMENT SYSTEM INSPECTION FORM --
AITKIN COUNTY, MINNESOTA**

2022-8831

Township Jewell Date of Inspection 7/28/2023 I App. Number 47074

Owner Matthew + Katy Hamilton Parcel Number 14-0-024700

Project Address 24917 435th St. Installer Brad Eddy

City McGregor Zip Code 55760 TI ZBR Mound

New Repair

SETBACKS:

Buildings to tank(s) _____
Buildings to drainfield _____
Well(s) 50' or 100' _____
Lake/Creek/Wetland _____

SEPTIC TANKS: New Existing

Number of tanks installed (1) T&C 1650 combo
Liquid capacity and type 1120 part combo
Type of baffle Plastic

Inspection pipes _____


Manholes size 24"

Manhole to grade Yes No

PUMPS: New Existing

Tank capacity and type 533 part combo
Pump manufacturer & model # Zoeller BNS3
Horsepower & GPM 1/2 HP 22 GPM
Feet of head 13'
Gallons per cycle 75 GPC
Size of discharge line 2"
Type & location of alarm Elec. on tank
Water meter _____

DRAWING OF SYSTEM: (include soils)

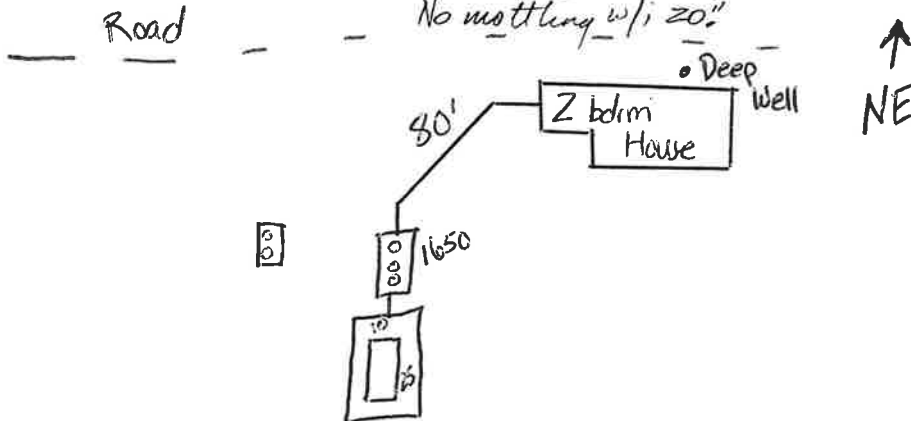

Inspector's Comments: _____

Inspector's Signature Bryan Hargrave Installer's Signature _____

AITKIN COUNTY
CERTIFICATE OF INSTALLATION/~~NOTICE OF NONCOMPLIANCE~~

This certificate of installation/~~notice of noncompliance~~ has been issued this 24th day of October, 2023 to certify compliance/~~noncompliance~~ with Aitkin County's Subsurface Sewage Treatment System Ordinance.

The premises covered by this certificate are legally described as: _____
SW SW LESS S1/2 SW SW SW & LOT 8 S OF SOO RR R/W

Section 15 Township 48 Range 24 Lake N/A
PERMIT NO. 47074 Owner Name Matthew & Katy Hamilton
Address 24917 435th Street
Installer Name _____ Brad Eddy
Type of System Inspected _____ Type I 2 Bedroom Mound
Parcel Number 14-0-024700

The certificate of installation/~~notice of noncompliance~~ was based on No 1 of the following:

- 1) Inspection of the installation or construction as in accordance with the above referenced permit and application design.

- 2) Review of as-built plans submitted in accordance with Subdivision 9.2 D of Aitkin County's Subsurface Sewage Treatment System Ordinance.

If the above permitted subsurface sewage treatment system is in noncompliance with Aitkin County's Subsurface Sewage Treatment System Ordinance, then the following shall serve as a Notice of Violation:

- 1) Statement of the findings of fact through inspections or investigations:

- 2) List of specific violations of Ordinance: _____

- 3) Requirements for correction or removal of violations: _____

- 4) Time schedule for compliance: _____

Failure to correct or remove the above violation(s) will result in this matter being turned over to the Aitkin County Attorney's Office for further legal action, which may result in revocation of licenses or registrations, fines and/or imprisonment.

INSPECTOR SIGNATURE _____

