

**AITKIN COUNTY**  
**CERTIFICATE OF INSTALLATION/~~NOTICE OF NONCOMPLIANCE~~**

This certificate of installation/~~notice of noncompliance~~ has been issued this 22nd day of September, 2022 to certify compliance/~~noncompliance~~ with Aitkin County's Subsurface Sewage Treatment System Ordinance.

The premises covered by this certificate are legally described as: \_\_\_\_\_  
1.34 ACS OF LOT 2 IN DOC #471973

Section 12 Township 46 Range 46 Lake Hanging Kettle  
PERMIT NO. 47057 Owner Name Mark & Regan Allen Trustees  
Address 40657 321st Ln Aitkin, Mn 56431  
Installer Name Schrupp Excavating  
Type of System Inspected 5 Bdrm Type I pressure bed  
Parcel Number 07-0-026204

The certificate of installation/~~notice of noncompliance~~ was based on No 1 of the following:

- 1) Inspection of the installation or construction as in accordance with the above referenced permit and application design.
  
- 2) Review of as-built plans submitted in accordance with Subdivision 9.2 D of Aitkin County's Subsurface Sewage Treatment System Ordinance.

If the above permitted subsurface sewage treatment system is in noncompliance with Aitkin County's Subsurface Sewage Treatment System Ordinance, then the following shall serve as a Notice of Violation:

- 1) Statement of the findings of fact through inspections or investigations:

\_\_\_\_\_

- 2) List of specific violations of Ordinance: \_\_\_\_\_

\_\_\_\_\_

- 3) Requirements for correction or removal of violations: \_\_\_\_\_

\_\_\_\_\_

- 4) Time schedule for compliance: \_\_\_\_\_

Failure to correct or remove the above violation(s) will result in this matter being turned over to the Aitkin County Attorney's Office for further legal action, which may result in revocation of licenses, fines and/or imprisonment.

INSPECTOR SIGNATURE 

**SUBSURFACE SEWAGE TREATMENT SYSTEM INSPECTION FORM  
AITKIN COUNTY, MINNESOTA**

Township Farm Island Date of Inspection 9-22-22 App. Number 2022-008897

Owner Mark & Regan Allen Trustees Parcel Number 07-0-026204

Project Address 42657 321st Ln Installer Schroff

City Aitkin Zip Code 56431

New  Repair

**SETBACKS:**

Buildings to tank(s) 15'  
Buildings to drainfield ~70'  
Well(s) 50' or 100' >100'  
Lake/Creek/Wetland >200'

SEPTIC TANKS: New  Existing

Number of tanks installed Wipac Tanks  
Liquid capacity and type 1500 (1000/500)  
Type of baffle Plastic  
Inspection pipes —  
Manholes size 3 @ 24"  
Manhole to grade Yes  No

PUMPS: New  Existing

Tank capacity and type 75/5  
Pump manufacturer & model # Zeller 452  
Horsepower & GPM .5 37 gpm  
Feet of head 22  
Gallons per cycle 180  
Size of discharge line 2"  
Type & location of alarm elec @ Tank  
Water meter —

DIST. or DROP BOX & TYPE \_\_\_\_\_


**TRENCHES, BEDS, OR GRAVELLESS LEACHFIELD:**

Trench/Bed depth 20"  
Trench/Bed length 46'  
Trench/Bed bottom width 12"  
Trench spacing \_\_\_\_\_  
Drainfield rock below pipe 9'  
Size of gravelless pipe \_\_\_\_\_  
Depth of backfill 12"  
Absorption area: square feet 736  
lineal feet \_\_\_\_\_

**MOUNDS:**

Percent slope \_\_\_\_\_  
Upslope sand width \_\_\_\_\_  
Downslope sand width \_\_\_\_\_  
Sideslope sand width \_\_\_\_\_  
Drainfield rock below pipe \_\_\_\_\_  
Depth of sand below rock \_\_\_\_\_  
Perforation size & spacing 1/4" x 4"  
Pipe size & spacing 1 1/2" x 4"  
Dimensions of rock bed \_\_\_\_\_  
Dimensions of sand base \_\_\_\_\_  
Final cover \_\_\_\_\_

**DRAWING OF SYSTEM: (include soils)**

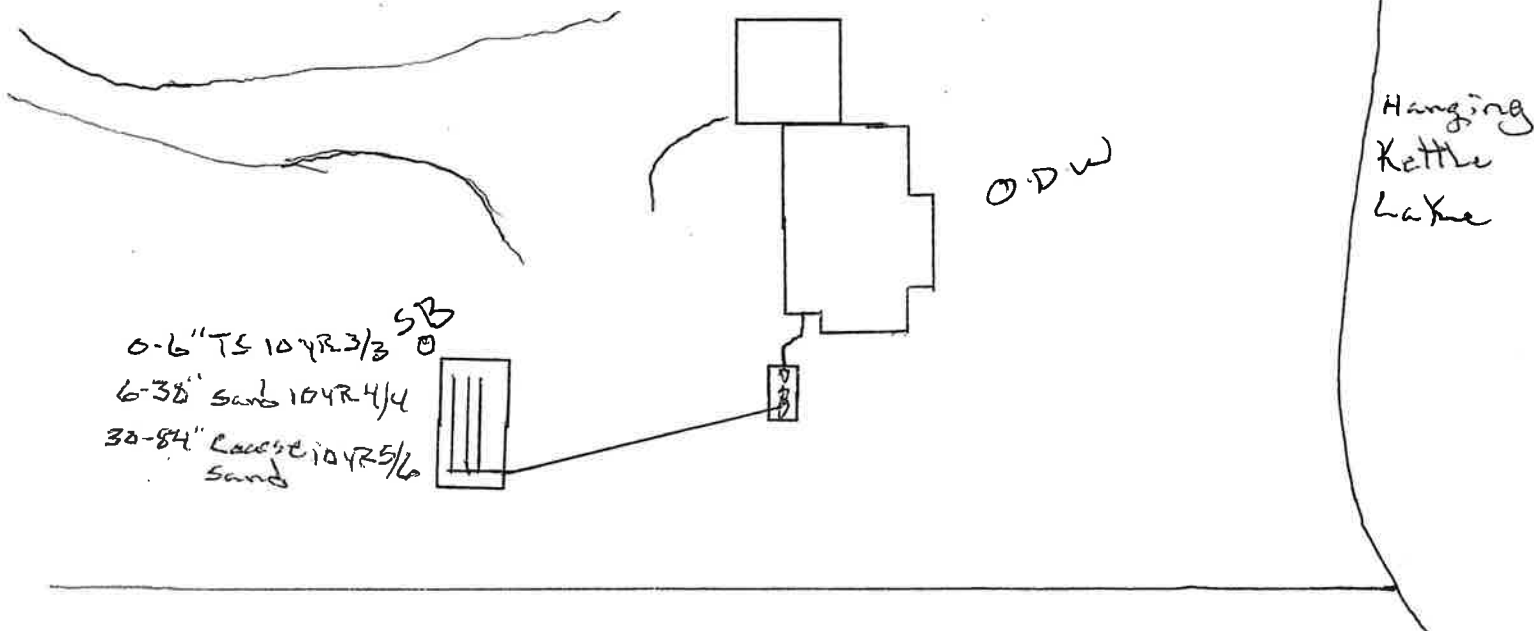

Inspector's Comments: \_\_\_\_\_

Inspector's Signature [Signature] Installer's Signature [Signature]