

**SUBSURFACE SEWAGE TREATMENT SYSTEM INSPECTION FORM  
AITKIN COUNTY, MINNESOTA**

Township Shannon Date of Inspection 7-2-22 App. Number 2022-008905

Owner Michael Podvalny Parcel Number 29-0-023600

Project Address 1799 51st Ln Installer Darius Excavating

City McGregor Zip Code 55760

New  Repair  Type II siphon DIST. or DROP BOX & TYPE \_\_\_\_\_

**SETBACKS:**

Buildings to tank(s) 220' TRENCHES, BEDS, OR GRAVELLESS LEACHFIELD: \_\_\_\_\_

Buildings to drainfield Out house tank Trench/Bed depth \_\_\_\_\_

Well(s) 50' or 100' or 100' No well Trench/Bed length \_\_\_\_\_

Lake/Creek/Wetland \_\_\_\_\_ Trench/Bed bottom width \_\_\_\_\_

Drainfield rock below pipe \_\_\_\_\_ Trench spacing \_\_\_\_\_

SEPTIC TANKS: New  Existing \_\_\_\_\_ Drainfield rock below pipe \_\_\_\_\_

Number of tanks installed 1 Size of gravelless pipe \_\_\_\_\_

Liquid capacity and type 300 g. Norwest Depth of backfill \_\_\_\_\_

Type of baffle \_\_\_\_\_ Absorption area: square feet \_\_\_\_\_

Inspection pipes \_\_\_\_\_ lineal feet \_\_\_\_\_

Manholes size 20" MOUNDS: \_\_\_\_\_

Manhole to grade Yes  No \_\_\_\_\_ Percent slope \_\_\_\_\_

PUMPS: New \_\_\_\_\_ Existing \_\_\_\_\_ Upslope sand width \_\_\_\_\_

Tank capacity and type \_\_\_\_\_ Downslope sand width \_\_\_\_\_

Pump manufacturer & model # \_\_\_\_\_ Sideslope sand width \_\_\_\_\_

Horsepower & GPM \_\_\_\_\_ Drainfield rock below pipe \_\_\_\_\_

Feet of head \_\_\_\_\_ Depth of sand below rock \_\_\_\_\_

Gallons per cycle \_\_\_\_\_ Perforation size & spacing \_\_\_\_\_


Size of discharge line \_\_\_\_\_ Pipe size & spacing \_\_\_\_\_

Type & location of alarm \_\_\_\_\_ Dimensions of rock bed \_\_\_\_\_

Water meter \_\_\_\_\_ Dimensions of sand base \_\_\_\_\_

Final cover \_\_\_\_\_

DRAWING OF SYSTEM: (include soils) No well

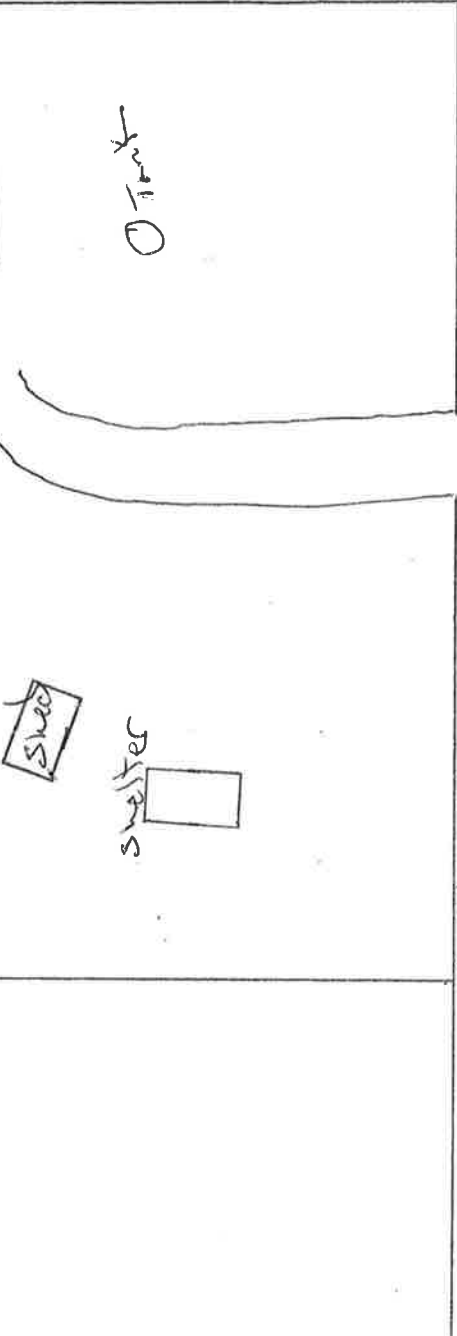

Inspector's Comments: \_\_\_\_\_

Inspector's Signature [Signature] Installer's Signature \_\_\_\_\_

Rev: 1/13 White - County Yellow - Applicant Pink - Installer