

AITKIN COUNTY
CERTIFICATE OF INSTALLATION/~~NOTICE OF NONCOMPLIANCE~~

This certificate of installation/~~notice of noncompliance~~ has been issued this 8th day of November, 2022 to certify compliance/~~noncompliance~~ with Aitkin County's Subsurface Sewage Treatment System Ordinance.

The premises covered by this certificate are legally described as: Lots 7&8 Blk 2 Charwood Estates

Section 29 Township 46 Range 26 Lake _____

PERMIT NO. 47059 Owner Name Cole Espeseth

Address 29366 381st Pl Aitkin, Mn 56431

Installer Name Self install

Type of System Inspected 4 Bdrm Type I Chamber Trench Septic

Parcel Number 24-1-124900/24-1-125000

The certificate of installation/~~notice of noncompliance~~ was based on No 1 of the following:

- 1) Inspection of the installation or construction as in accordance with the above referenced permit and application design.

- 2) Review of as-built plans submitted in accordance with Subdivision 9.2 D of Aitkin County's Subsurface Sewage Treatment System Ordinance.

If the above permitted subsurface sewage treatment system is in noncompliance with Aitkin County's Subsurface Sewage Treatment System Ordinance, then the following shall serve as a Notice of Violation:

- 1) Statement of the findings of fact through inspections or investigations:

- 2) List of specific violations of Ordinance: _____

- 3) Requirements for correction or removal of violations: _____

- 4) Time schedule for compliance: _____

Failure to correct or remove the above violation(s) will result in this matter being turned over to the Aitkin County Attorney's Office for further legal action, which may result in revocation of licenses, fines and/or imprisonment.

INSPECTOR SIGNATURE 

**SUBSURFACE SEWAGE TREATMENT SYSTEM INSPECTION FORM
AITKIN COUNTY, MINNESOTA**

Township Nordland Date of Inspection 11-8-22 App. Number 2022-009014

Owner Cole Espeseth Parcel Number 24-1-124900/24-1-12500

Project Address 29316 381st PL Installer Self

City Aitkin Zip Code 56431

New Repair

SETBACKS:
Buildings to tank(s) 41'
Buildings to drainfield ~ 70'
Well(s) 50' or 100' No well yet
Lake/Creek/Wetland —

SEPTIC TANKS: New Existing
Number of tanks installed 1 Sanderson
Liquid capacity and type 1500 porcelain
Type of baffle Plastic
Inspection pipes —
Manholes size 2 @ 24"
Manhole to grade Yes No


PUMPS: New Existing
Tank capacity and type —
Pump manufacturer & model # —
Horsepower & GPM —
Feet of head —
Gallons per cycle —
Size of discharge line —
Type & location of alarm —
Water meter —

DIST. or DROP BOX & TYPE To FF tile

TRENCHES, BEDS, OR GRAVELLESS LEACHFIELD:
Trench/Bed depth 24"
Trench/Bed length 3 @ 68'
Trench/Bed bottom width 3'
Trench spacing 10'
Drainfield rock below pipe 12" chambers
~~Size of gravelless pipe~~ —
Depth of backfill 12"
Absorption area: square feet 610
lineal feet 203

MOUNDS:
Percent slope —
Upslope sand width —
Downslope sand width —
Sideslope sand width —
Drainfield rock below pipe —
Depth of sand below rock —
Perforation size & spacing —
Pipe size & spacing —
Dimensions of rock bed —
Dimensions of sand base —
Final cover —

DRAWING OF SYSTEM: (include soils)

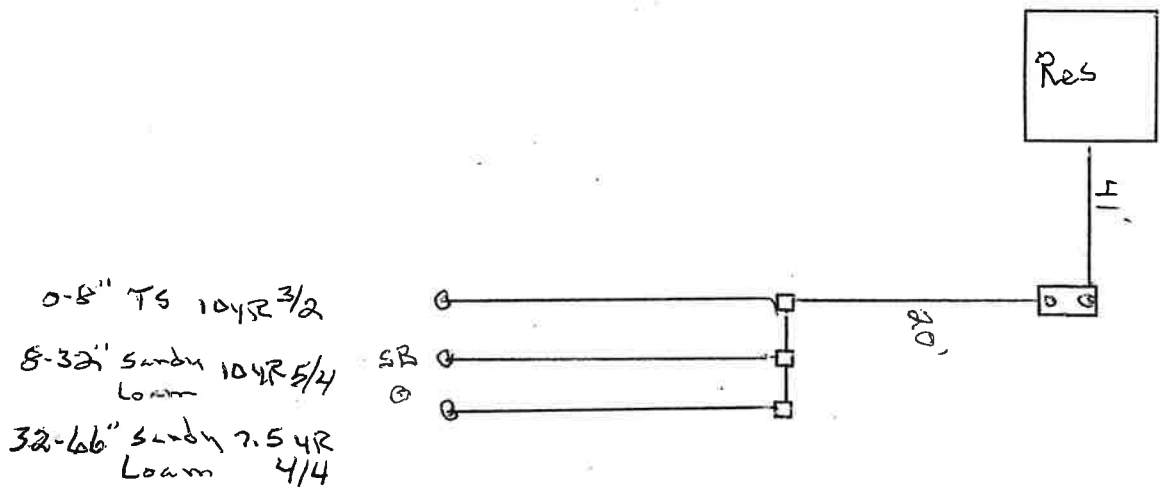

Inspector's Comments: _____

Inspector's Signature L. [Signature] Installer's Signature _____