

**SUBSURFACE SEWAGE TREATMENT SYSTEM INSPECTION FORM
AITKIN COUNTY, MINNESOTA**

Township Hill Lake Date of Inspection 7-22-22 App. Number 2022-009080

Owner Matt & Jodi Schwagerl Parcel Number 12-0-038500

Project Address 66654 368th PL Installer McNeil Exc.

City Hill City Zip Code 55748

New Repair DIST. or DROP BOX & TYPE _____

SETBACKS: TRENCHES, BEDS, OR GRAVELLESS LEACHFIELD:


Buildings to tank(s) No permanent/camp Trench/Bed depth _____
 Buildings to drainfield None Trench/Bed length _____
 Well(s) 50' or 100' > 50' _____ Trench/Bed bottom width _____
 Lake/Creek/Wetland _____ Trench spacing _____
 Drainfield rock below pipe _____
 Size of gravelless pipe _____

SEPTIC TANKS: New Existing _____
 Number of tanks installed 2
 Liquid capacity and type 1500 gal. Polyprop.
 Type of baffle Plastic
 Absorption area: square feet _____
 lineal feet _____

MOUNDS:
 Inspection pipes _____
 Manholes size 2 @ 24"
 Manhole to grade Yes No _____

PUMPS: New _____ Existing _____
 Tank capacity and type _____
 Pump manufacturer & model # _____
 Horsepower & GPM _____
 Feet of head _____
 Gallons per cycle _____
 Size of discharge line _____
 Type & location of alarm _____
 Water meter _____

DRAWING OF SYSTEM: (include soils)

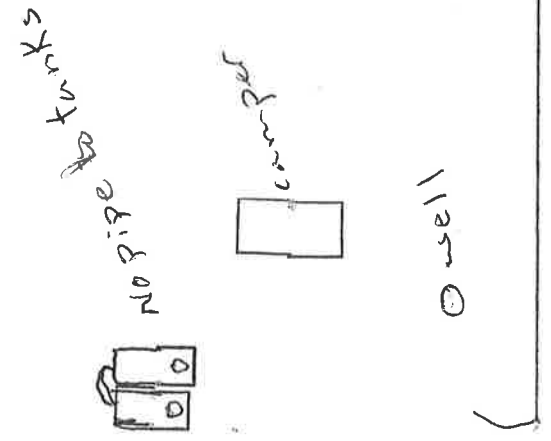

Inspector's Comments: 368th PL.

Inspector's Signature [Signature] Installer's Signature _____