

Long Running ROST

JACOBSON PRECAST CONCRETE, LLC

TANK INSTALLATION INSTRUCTIONS

Model # 1650 Date Built: 4.29.22 Gallons: 1650 Bury Depth 1'
 Model # #2 Date Built: _____ Gallons: _____ Bury Depth _____

SITE CONDITION:

The site must be accessible to large, heavy trucks. Free of items like trees, stumps, overhead wires, etc. That could interfere with delivery or installation and allows trucks to within 3 to 5 ft of placement excavation.

EXCAVATION:

Excavation should be approximately 12" minimum larger than tank size to allow for adequate back fill. This may vary with soil conditions. Excavation shall have a level bottom so the weight bears on the outside walls of the tank.

BEDDING:

Each tank should be placed on about 6" of proper bedding material leveled, and should be compacted to minimum 95% compaction if tested, to ensure the life of the tank structure. Bedding must be capable of bearing the weight of the tank. Bedding material shall have the ability of 100% to pass through a 1/2" screen.

WATER TABLE:

When tanks are being placed where water levels can potentially be higher than the elevation of the tank cover, an alternate location should be considered. If water table is high installer must also consider the tank may float, if this is a possibility tank must be tied down before backfilling.

BACKFILL MATERIAL:

Sidewall of tanks require dry backfill materials that have the ability of 100% to be able to pass through a 2" screen and a minimum of 12" on all sides from the bottom to top of tank. Backfill material shall be placed to avoid impact loads on sidewall of the tank.

COVER MATERIAL:

Cover material shall be dry soil, material that has the ability of 100% to be able to pass through a 2' screen. Cover material shall be mounded over tank and around risers to direct run-off away from both.

INLET & OUTLET:

Pipe not to exceed 1" past the interior wall of tank where a baffle is used.

BURIAL DEPTH: Tanks to be installed according to model's maximum bury recommendations:

AITKIN COUNTY
CERTIFICATE OF INSTALLATION/~~NOTICE OF NONCOMPLIANCE~~

This certificate of installation/~~notice of noncompliance~~ has been issued this 22nd day of July, 2022 to certify compliance/~~noncompliance~~ with Aitkin County's Subsurface Sewage Treatment System Ordinance.

The premises covered by this certificate are legally described as: N 475 FT OF LOT 1 LESS PTS IN DOCS 329875, 331291, 335607 & 356892

Section 11 Township 52 Range 26 Lake _____
PERMIT NO. 47122 Owner Name Jean Rost Et Al
Address 68654 350th Pl Hill City, Mn 55748
Installer Name Lange's Nursery & Landscape
Type of System Inspected Type II Holding Tank
Parcel Number 12-0-017300

The certificate of installation/~~notice of noncompliance~~ was based on No 1 of the following:

- 1) Inspection of the installation or construction as in accordance with the above referenced permit and application design.

- 2) Review of as-built plans submitted in accordance with Subdivision 9.2 D of Aitkin County's Subsurface Sewage Treatment System Ordinance.

If the above permitted subsurface sewage treatment system is in noncompliance with Aitkin County's Subsurface Sewage Treatment System Ordinance, then the following shall serve as a Notice of Violation:

- 1) Statement of the findings of fact through inspections or investigations:

- 2) List of specific violations of Ordinance: _____

- 3) Requirements for correction or removal of violations: _____

- 4) Time schedule for compliance: _____

Failure to correct or remove the above violation(s) will result in this matter being turned over to the Aitkin County Attorney's Office for further legal action, which may result in revocation of licenses, fines and/or imprisonment.

INSPECTOR SIGNATURE _____

L. - - Purock

**SUBSURFACE SEWAGE TREATMENT SYSTEM INSPECTION FORM
AITKIN COUNTY, MINNESOTA**

Township Hill Lake Date of Inspection 7-22-22 App. Number 2022-009125

Owner Sean Ross Etal Parcel Number 12-0-017300

Project Address 68654 350th Pl. Installer Lange's Nursery & Landscape
City Hill City Zip Code 55748

New Repair

SETBACKS:

Buildings to tank(s) 28'
Buildings to drainfield _____
Well(s) 50' or 100' 55 - shallow well
Lake/Creek/Wetland _____


SEPTIC TANKS:

New Existing
Number of tanks installed 1
Liquid capacity and type 1650 polypropylene
Type of baffle Plastic
Inspection pipes _____
Manholes size 2 @ 24" 1 @ 20"
Manhole to grade Yes No

PUMPS:

New Existing
Tank capacity and type _____
Pump manufacturer & model # _____
Horsepower & GPM _____
Feet of head _____
Gallons per cycle _____
Size of discharge line _____
Type & location of alarm Mechanical
Water meter _____

DRAWING OF SYSTEM: (include soils)

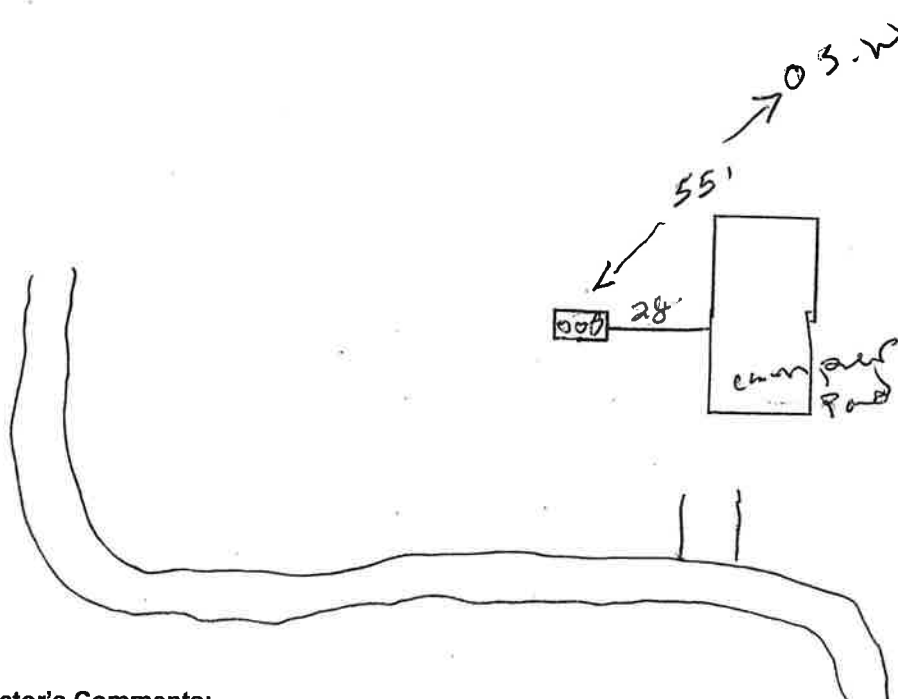

DIST. or DROP BOX & TYPE _____

TRENCHES, BEDS, OR GRAVELLESS LEACHFIELD:

Trench/Bed depth _____
Trench/Bed length _____
Trench/Bed bottom width _____
Trench spacing _____
Drainfield rock below pipe _____
Size of gravelless pipe _____
Depth of backfill _____
Absorption area: square feet _____
lineal feet _____

MOUNDS:

Percent slope _____
Upslope sand width _____
Downslope sand width _____
Sideslope sand width _____
Drainfield rock below pipe _____
Depth of sand below rock _____
Perforation size & spacing _____
Pipe size & spacing _____
Dimensions of rock bed _____
Dimensions of sand base _____
Final cover _____

Inspector's Comments: _____

Inspector's Signature [Signature] Installer's Signature _____