

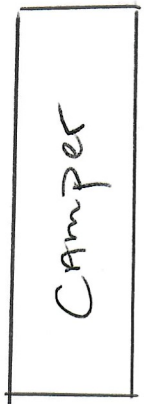
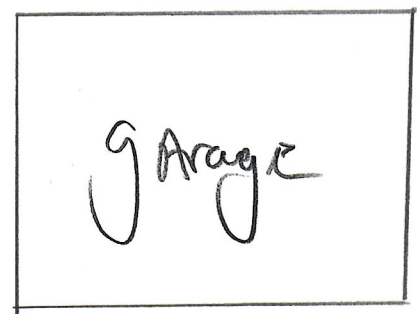


⊗ Bm  
NML  
IN  
TREE

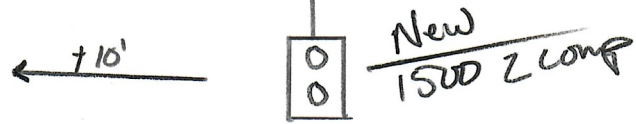

Property line

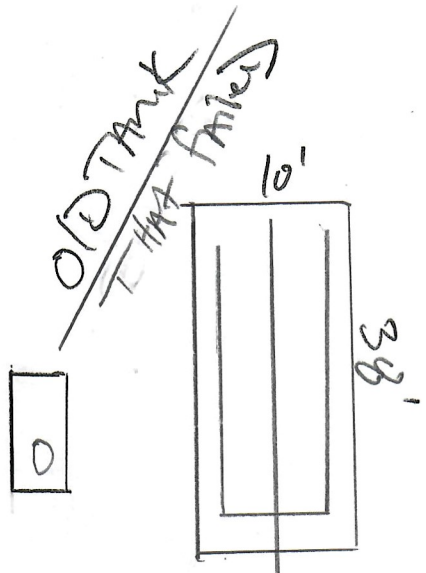

TANK EIV - 4.9  
Bm EIV - 6.9

1/20/19



well location

Tank installed 2 ft into ground

Parcel # 07-1-138500

Drinking