

**AITKIN COUNTY**  
**CERTIFICATE OF INSTALLATION/~~NOTICE OF NONCOMPLIANCE~~**

This certificate of installation/~~notice of noncompliance~~ has been issued this 26th day of July, 2022 to certify ~~compliance~~ noncompliance with Aitkin County's Subsurface Sewage Treatment System Ordinance.

The premises covered by this certificate are legally described as: PT LOT 2 AS IN DOC 472908 (PARCEL D)

Section 19 Township 46 Range 27 Lake Thornton  
PERMIT NO. 47126 Owner Name Dennis & Sue Daniello Trust  
Address 30806 454th Ave Aitkin, Mn 56431  
Installer Name Schrupp Excavating  
Type of System Inspected 2 Bdrm Type I Mound  
Parcel Number 07-0-037800

The certificate of installation/~~notice of noncompliance~~ was based on No 1 of the following:

- 1) Inspection of the installation or construction as in accordance with the above referenced permit and application design.
  
- 2) Review of as-built plans submitted in accordance with Subdivision 9.2 D of Aitkin County's Subsurface Sewage Treatment System Ordinance.

If the above permitted subsurface sewage treatment system is in noncompliance with Aitkin County's Subsurface Sewage Treatment System Ordinance, then the following shall serve as a Notice of Violation:

- 1) Statement of the findings of fact through inspections or investigations:

\_\_\_\_\_

- 2) List of specific violations of Ordinance: \_\_\_\_\_

\_\_\_\_\_

- 3) Requirements for correction or removal of violations: \_\_\_\_\_

\_\_\_\_\_

- 4) Time schedule for compliance: \_\_\_\_\_

Failure to correct or remove the above violation(s) will result in this matter being turned over to the Aitkin County Attorney's Office for further legal action, which may result in revocation of licenses, fines and/or imprisonment.

INSPECTOR SIGNATURE



**SUBSURFACE SEWAGE TREATMENT SYSTEM INSPECTION FORM  
AITKIN COUNTY, MINNESOTA**

Township Farm Island Date of Inspection 7-21-22 <sup>Final</sup> App. Number 2022-009192

Owner Dennis & Sue Daniello Parcel Number 07-0-037800

Project Address 38806 454<sup>th</sup> Ave Installer Schopp Excavating

City Aitkin Zip Code 56431

New  Repair

**SETBACKS:**  
Buildings to tank(s) 18'  
Buildings to drainfield 40' - Rock bed  
Well(s) 50' or 100' \_\_\_\_\_  
Lake/Creek/Wetland \_\_\_\_\_


**SEPTIC TANKS:** New  Existing \_\_\_\_\_  
Number of tanks installed 1 Whipple's Comb  
Liquid capacity and type 1500 gal per cycle  
Type of baffle Plastic  
Inspection pipes \_\_\_\_\_  
Manholes size 3 @ 24"  
Manhole to grade Yes  No \_\_\_\_\_

**PUMPS:** New  Existing \_\_\_\_\_  
Tank capacity and type 500 gal per cycle  
Pump manufacturer & model # Zoller 152  
Horsepower & GPM 1/2 18 gpm  
Feet of head 15'  
Gallons per cycle 25  
Size of discharge line 2"  
Type & location of alarm elec @ Tank  
Water meter \_\_\_\_\_

**DIST. or DROP BOX & TYPE** \_\_\_\_\_  
**TRENCHES, BEDS, OR GRAVELLESS LEACHFIELD:**  
Trench/Bed depth \_\_\_\_\_  
Trench/Bed length \_\_\_\_\_  
Trench/Bed bottom width \_\_\_\_\_  
Trench spacing \_\_\_\_\_  
Drainfield rock below pipe \_\_\_\_\_  
Size of gravelless pipe \_\_\_\_\_  
Depth of backfill \_\_\_\_\_  
Absorption area: square feet \_\_\_\_\_  
lineal feet \_\_\_\_\_

**MOUNDS:**  
Percent slope 2%  
Upslope sand width 9'  
Downslope sand width 11'  
Sideslope sand width 9'  
Drainfield rock below pipe 9"  
Depth of sand below rock 2'  
Perforation size & spacing 1 1/4" x 3"  
Pipe size & spacing 1 1/2" x 3"  
Dimensions of rock bed 10x25  
Dimensions of sand base 28x42'  
Final cover 18" T 13" S

**DRAWING OF SYSTEM: (include soils)**

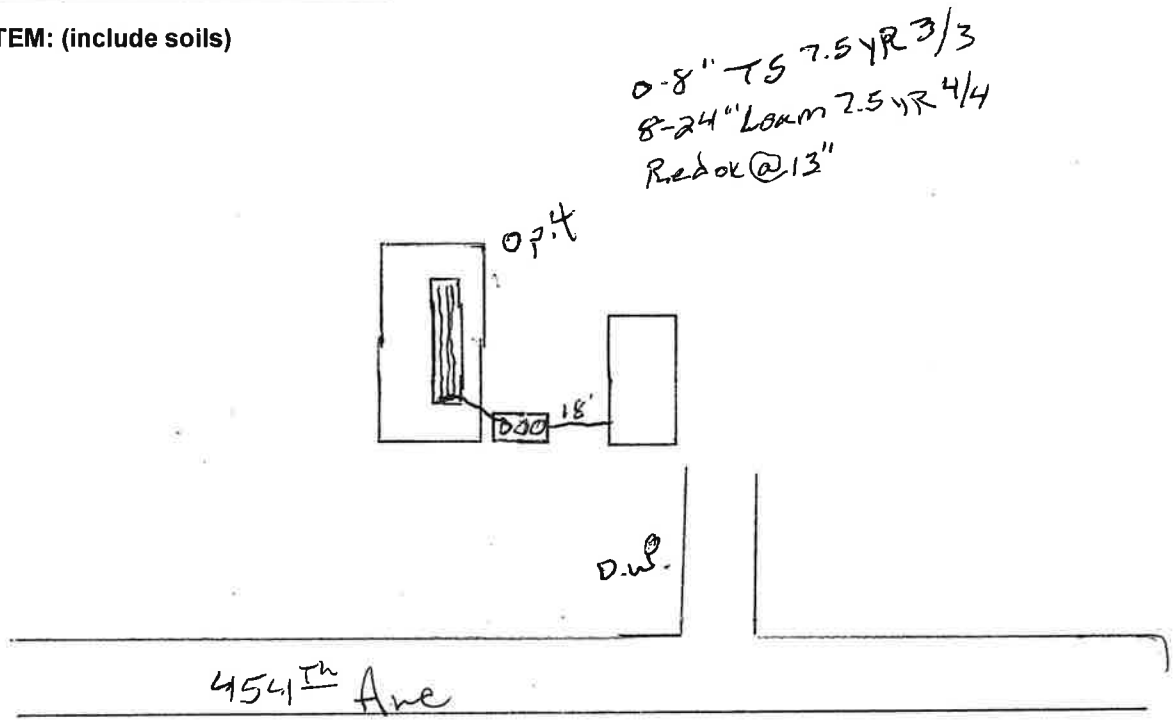

*0-8" TS 7.5' R 3/3  
8-24" Loxm 2.5' R 4/4  
Redox @ 13"*

Inspector's Comments: \_\_\_\_\_  
\_\_\_\_\_

Inspector's Signature \_\_\_\_\_ Installer's Signature Ryan Richards