

AITKIN COUNTY
CERTIFICATE OF INSTALLATION/~~NOTICE OF NONCOMPLIANCE~~

This certificate of installation/~~notice of noncompliance~~ has been issued this 24th day of October, 2022 to certify compliance/~~noncompliance~~ with Aitkin County's Subsurface Sewage Treatment System Ordinance.

The premises covered by this certificate are legally described as: _____
N 1/2 NW SW AND N 1/4 OF S 1/2 OF NW SW

Section 10 Township 43 Range 25 Lake _____
PERMIT NO. 47193 Owner Name John Schommer
Address 14454 250th Ave McGrath, Mn 56350
Installer Name Dave's Dirt Work
Type of System Inspected 2 Bdrm Type I Mound
Parcel Number 13-0-017302

The certificate of installation/~~notice of noncompliance~~ was based on No 1 of the following:

- 1) Inspection of the installation or construction as in accordance with the above referenced permit and application design.

- 2) Review of as-built plans submitted in accordance with Subdivision 9.2 D of Aitkin County's Subsurface Sewage Treatment System Ordinance.

If the above permitted subsurface sewage treatment system is in noncompliance with Aitkin County's Subsurface Sewage Treatment System Ordinance, then the following shall serve as a Notice of Violation:

- 1) Statement of the findings of fact through inspections or investigations:

- 2) List of specific violations of Ordinance: _____

- 3) Requirements for correction or removal of violations: _____

- 4) Time schedule for compliance: _____

Failure to correct or remove the above violation(s) will result in this matter being turned over to the Aitkin County Attorney's Office for further legal action, which may result in revocation of licenses, fines and/or imprisonment.

INSPECTOR SIGNATURE _____

L. - - Purock

**SUBSURFACE SEWAGE TREATMENT SYSTEM INSPECTION FORM
AITKIN COUNTY, MINNESOTA**

Township Idun Date of Inspection 8-15-22 Initial ^{10-24-22 Final} App. Number 2022-009212

Owner John Schammer Parcel Number 13-0-017302/13-0-017301
 Project Address 14454 250th Ave ^{Parcels combined 11-18-22} Installer Dave's Dirt Work

City McGoath Zip Code 56350

New Repair

SETBACKS:

Buildings to tank(s) No buildings yet
 Buildings to drainfield _____
 Well(s) 50' or 100' No well yet
 Lake/Creek/Wetland _____

SEPTIC TANKS: New Existing _____
 Number of tanks installed 1 Sacabson 1650
 Liquid capacity and type 1125 Precast
 Type of baffle Plastic
 Inspection pipes _____
 Manholes size 2 @ 24" 1 @ 20"
 Manhole to grade Yes No _____

PUMPS: New Existing _____
 Tank capacity and type 530 Precast
 Pump manufacturer & model # Liberty 253
 Horsepower & GPM .5 22 gpm
 Feet of head 12
 Gallons per cycle 75
 Size of discharge line 2"
 Type & location of alarm elec @ Tank
 Water meter _____

DIST. or DROP BOX & TYPE _____

TRENCHES, BEDS, OR GRAVELLESS LEACHFIELD:


Trench/Bed depth _____
 Trench/Bed length _____
 Trench/Bed bottom width _____
 Trench spacing _____
 Drainfield rock below pipe _____
 Size of gravelless pipe _____
 Depth of backfill _____
 Absorption area: square feet _____
 lineal feet _____

MOUNDS:

Percent slope 4
 Upslope sand width 8'
 Downslope sand width 20
 Sideslope sand width 8'
 Drainfield rock below pipe 9"
 Depth of sand below rock 28"
 Perforation size & spacing 1/4" x 2.5'
 Pipe size & spacing 1 1/2" x 3
 Dimensions of rock bed 10 x 25
 Dimensions of sand base 38 x 41
 Final cover 18" Top 12" sides

DRAWING OF SYSTEM: (include soils)

25 acre parcel
No setback issues

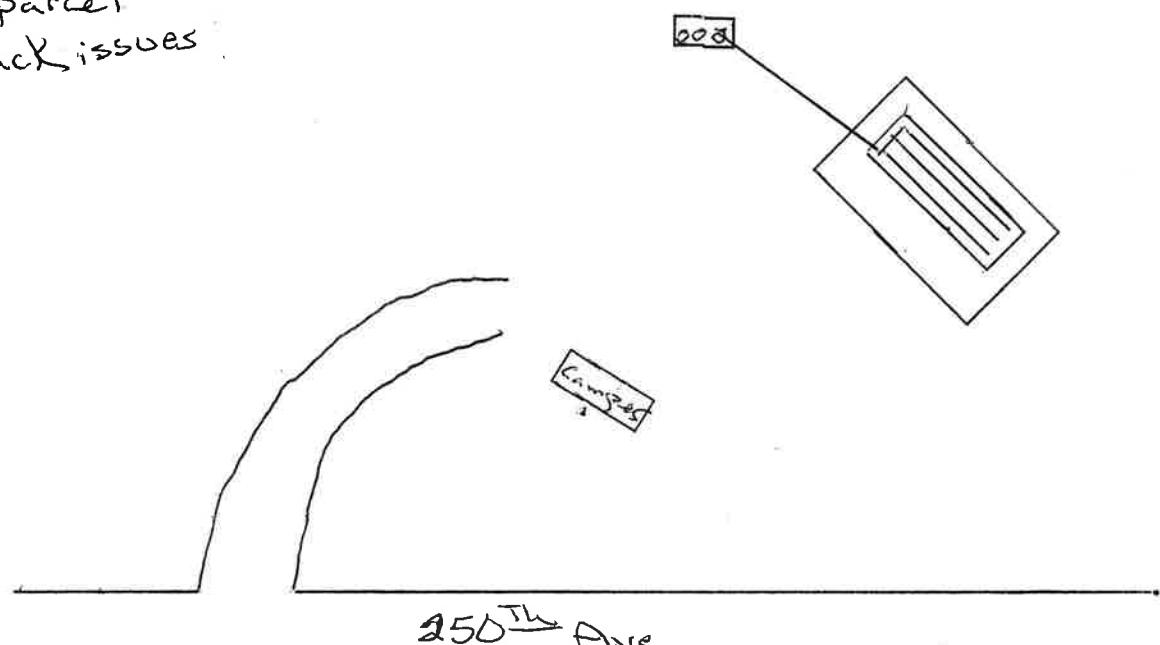

Inspector's Comments: _____

Inspector's Signature [Signature] Installer's Signature _____