

FIELD EVALUATION SHEET

PRELIMINARY EVALUATION DATE 8-5-2022, FIELD EVALUATION DATE 8-5-2022
PROPERTY OWNER: ISAAC DeCOOK PHONE 507-696-5217
ADDRESS: 11487 117th ST CITY, STATE, ZIP: FINLAYSON
LEGAL DESCRIPTION: _____
PIN# 34-1-071400 SEC 26 T 43 R 25 TWP NAME WAGNER
FIRE# LAKE/RIVER Pk LAKE CLASS 100 OHWL _____ FT

DESCRIPTION OF SOIL TREATMENT AREAS

	AREA #1	AREA #2	REFERENCE BM ELEV. <u>X</u> F
DISTURBED AREAS	YES <u>X</u> NO _____	YES <u>X</u> NO _____	REFERENCE BM DESCRIPTION _____
COMPACTED AREAS	YES _____ NO _____	YES _____ NO _____	<u>Replace Tank Need to</u>
FLOODING	YES _____ NO _____	YES _____ NO _____	<u>Use Pipe E.L.</u>
RUN ON POTENTIAL	YES _____ NO _____	YES _____ NO _____	_____
SLOPE %	_____	_____	_____
DIRECTION OF SLOPE	_____	_____	_____
LANDSCAPE POSITION	_____	_____	_____
VEGETATION TYPES	<u>LOW GROWS</u>		_____

DEPTH TO STANDING WATER OR MOTTLED SOIL: BORING# 1 _____, 1A _____, 2 _____, 2A _____

BOTTOM ELEVATION—FIRST TRENCH OR BOTTOM OF ROCK BED: #1 _____ FT., #2 _____ FT.

SOIL SIZING FACTOR: SITE #1 _____, SITE #2 _____

CONSTRUCTION RELATED ISSUES: TANK Replacement 1500 Single Comp Install Sirewings
Because of 10' To Home.

LIC# L2006 SITE EVALUATOR SIGNATURE: Dave Engdahl

SITE EVALUATOR NAME: DAVE ENGDALH TELEPHONE# 320-592-3606

LUG REVIEW _____ DATE _____

Comments: _____

SOIL BORING LOGS ON REVERSE SIDE


TANK Replacement - ONLY -

ISAAC DeLooK

Pine LK

34-1-071400

REMOVE ROUND
RING TANK

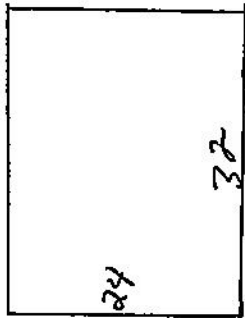


PROPERTY LINE

1500 gal
REPLACE METAL TANK
OLD ROUND TANK
LEAKS

Asph/Flt



DRIVE-WAY

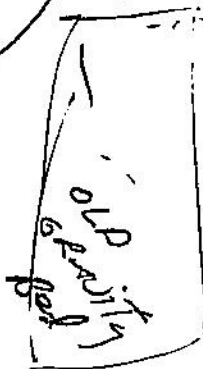

NOTE - TANK PROBABLY
NEEDS TO BE
INSTALLED SIDEWAYS
TO MAINTAIN 10' TO
HOME IF POSSIBLE

117th ST

Dave Engdahl

©2006

8/10/2022