

AITKIN COUNTY
CERTIFICATE OF INSTALLATION/~~NOTICE OF NONCOMPLIANCE~~

This certificate of installation/~~notice of noncompliance~~ has been issued this 8th day of August, 2022 to certify compliance/~~noncompliance~~ with Aitkin County's Subsurface Sewage Treatment System Ordinance.

The premises covered by this certificate are legally described as: Lot 8 Echo Hill Townsite

Section 26 Township 43 Range 22 Lake Pine
PERMIT NO. 47233 Owner Name Izaak & Morgan Decook
Address 11487 117th St Finlayson, Mn 55735
Installer Name Dave's Dirt Work
Type of System Inspected Type I tank replacement
Parcel Number 34-1-071400

The certificate of installation/~~notice of noncompliance~~ was based on No 2 of the following:

- 1) Inspection of the installation or construction as in accordance with the above referenced permit and application design.

- 2) Review of as-built plans submitted in accordance with Subdivision 9.2 D of Aitkin County's Subsurface Sewage Treatment System Ordinance.

If the above permitted subsurface sewage treatment system is in noncompliance with Aitkin County's Subsurface Sewage Treatment System Ordinance, then the following shall serve as a Notice of Violation:

- 1) Statement of the findings of fact through inspections or investigations:

2) List of specific violations of Ordinance: _____

3) Requirements for correction or removal of violations: _____

4) Time schedule for compliance: _____

Failure to correct or remove the above violation(s) will result in this matter being turned over to the Aitkin County Attorney's Office for further legal action, which may result in revocation of licenses, fines and/or imprisonment.

INSPECTOR SIGNATURE




Esmae DeCook

Pine LK

34-1-071400

REMOVE ROUND
RING
TANK

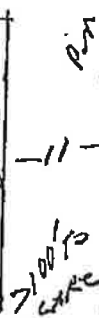

DEPLETED

DRIVE-WAY



- BM100 Bottom of Sidew
- 979 Top of Pipe at Home
- 976 TANK inlet
- 974 TANK out Let
- 971 Pipe at Bed

1500 gal Jacobson
Replace Manhole Tank
OLD Round Tank
LeakS

Note - TANK PROBABLY
NEEDS TO BE
INSTALLED SIDEWAYS
TO MAINTAIN 10' TO
HOME IF POSSIBLE

117th ST

Bove Englund

2006

8/10/2022 updated 8/27/2022

AS-Built