


* Rotate Shed to meet mound setback

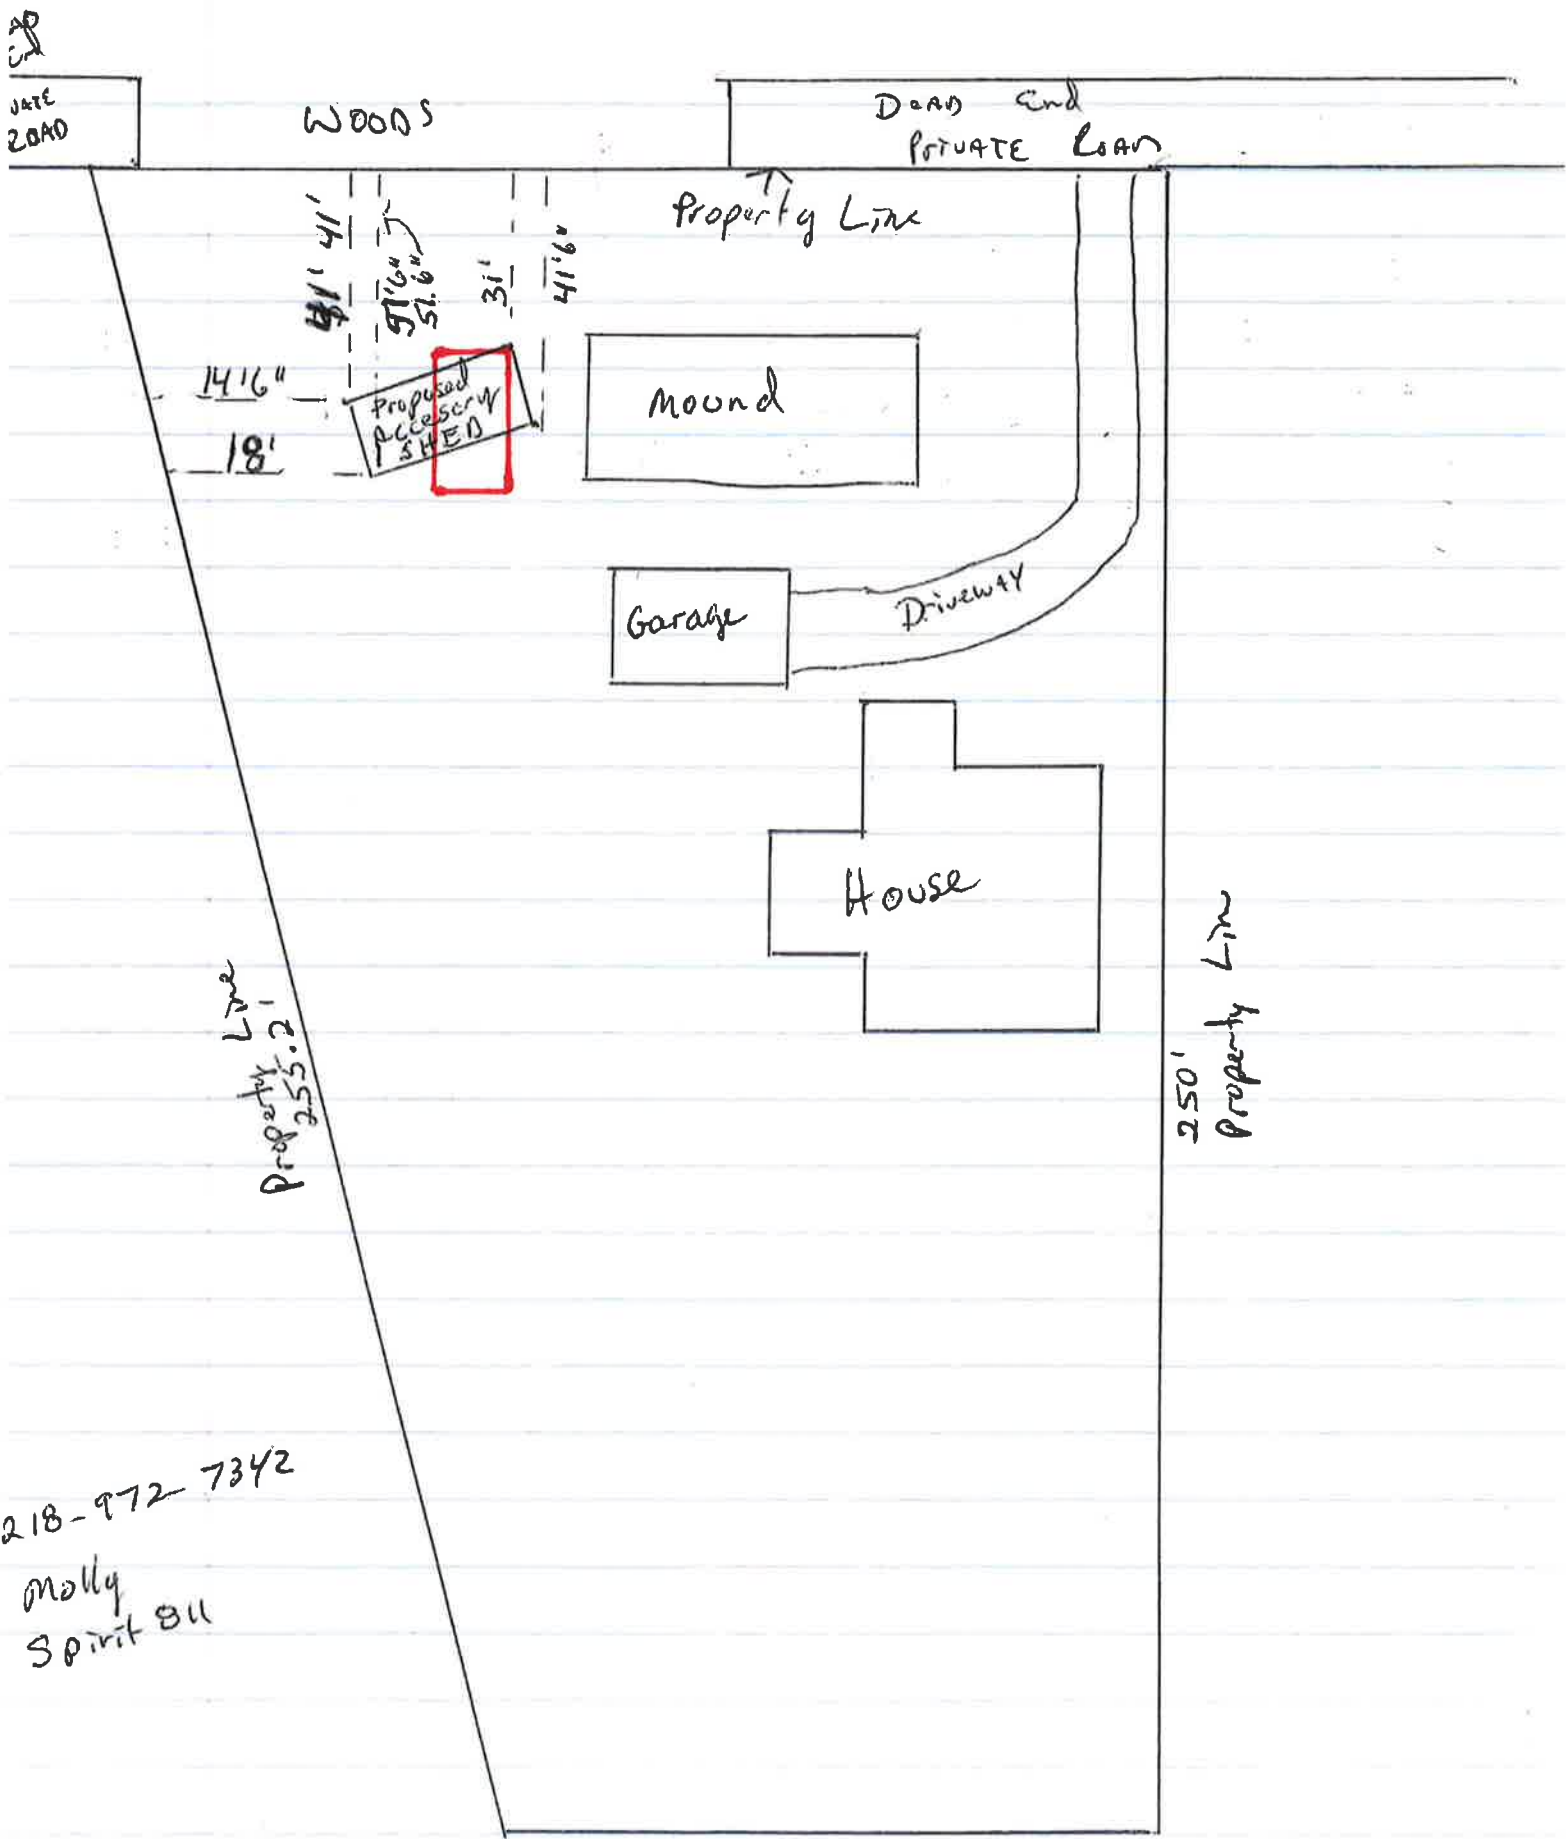

218-972-7342
Molly Spirit Bu

Spirit LAKE