

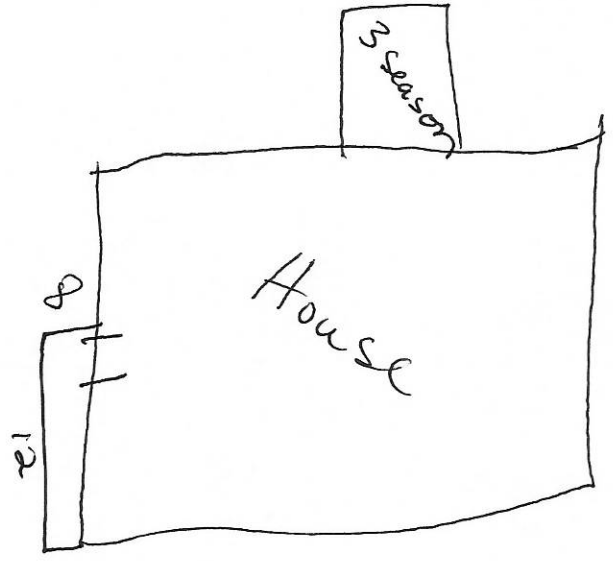


Septic

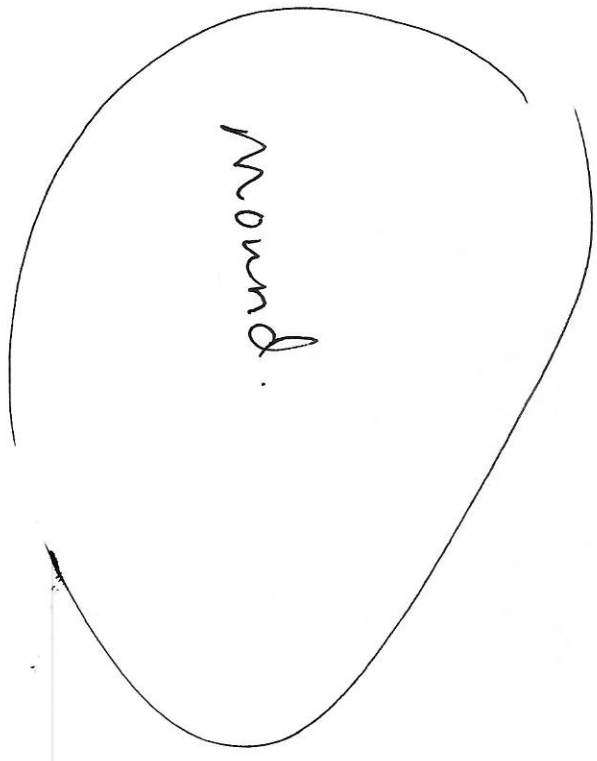

← New Deck
12x8

Well

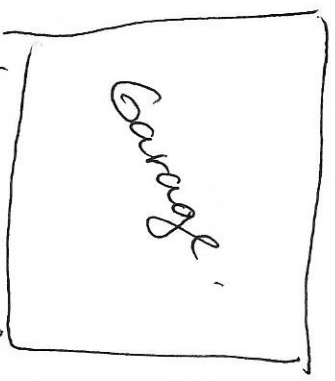

Drive way

drive way

