


# { Inspection Drawing }

Property Owner: Thomas Whalen Date: 5/28/2022 Designer's Initials: JB  
 Parcel ID. Number: 07-0-071600 Address: 44609 285th Ln. Aitkin MN 56431  
 Aitkin Co. One Inch = 40ft.'

Drainfield As/built was confirmed and used for parts of this inspection

*Install New 1000 gal Septic Tank*

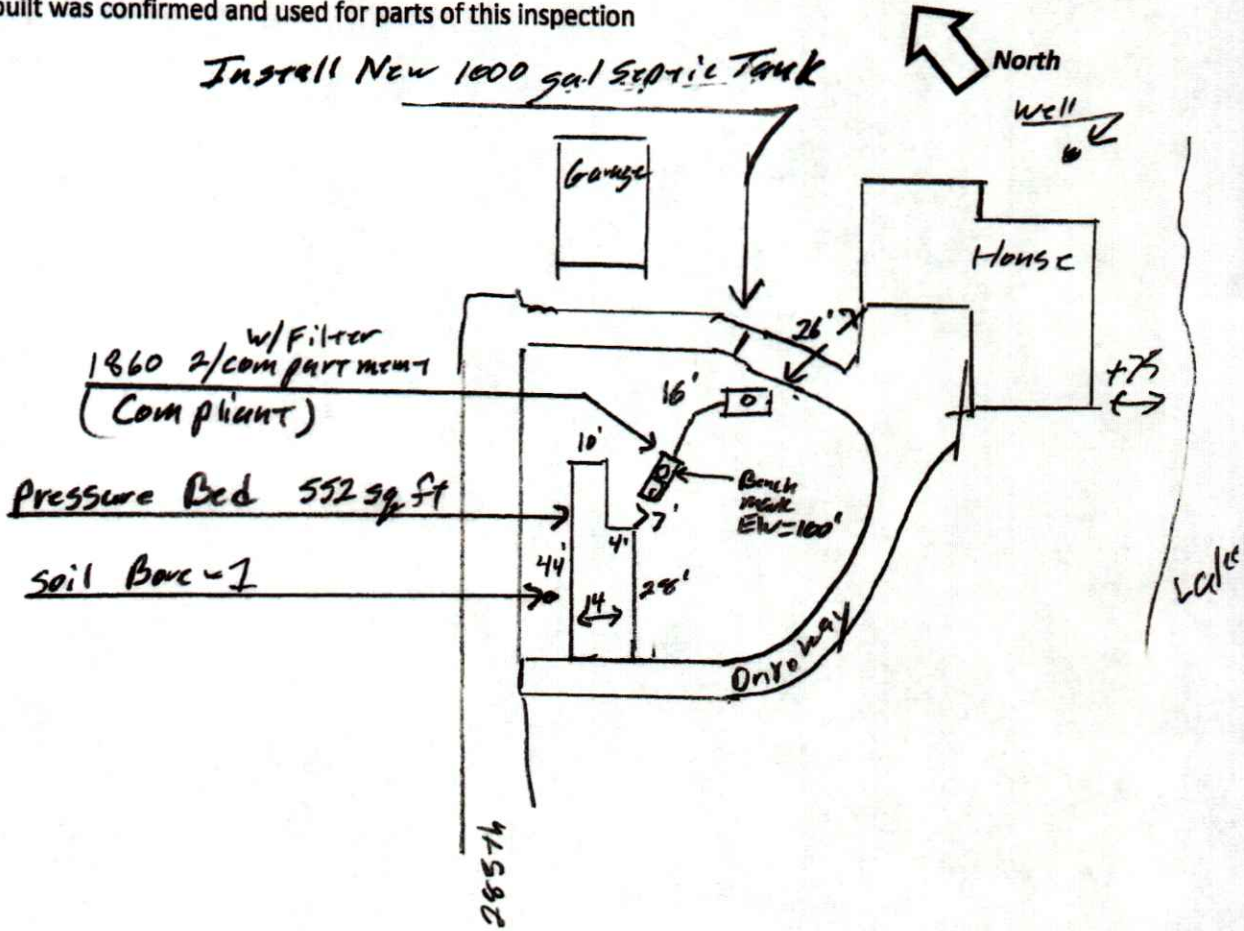

Elev. Of ground at 1st Septic Tank = 100.1'

Inlet 1st Septic Tank Elev. = 98.3'

Elev. Of ground at 2nd Septic Tank = 99.8'

Inlet 2nd Septic Tank Elev. = 97.6'

Grade near house Elev.= 100.4'

Elev. Of grade at center of pressure bed Elev.= 99.6'

Elev. Of bottom of rock bed Elev. = 97.6'

12" of Cover + 12 " rock = 2 ft.

Bench Mark Elev. =100 ' Top of Pump tank Manhole cover.

Pump Elev. = 94.2'

SB - 1 Top of Ground Soil Boring Elev. = 99'

Depth ( in.)	Texture	Color
0 - 10	Top Soil	10YR3/2
10 - 54	Sandy Loam	10YR5/4

Elev.= 94.5'

SB - Top of Ground Elev.

Depth ( in.)	Texture	Color

5/19/2009 Install Inspection Report States 9 inches of rock under pipe