

AITKIN COUNTY
CERTIFICATE OF INSTALLATION/~~NOTICE OF NONCOMPLIANCE~~

This certificate of installation/~~notice of noncompliance~~ has been issued this 24th day of June, 2022 to certify compliance/~~noncompliance~~ with Aitkin County's Subsurface Sewage Treatment System Ordinance.

The premises covered by this certificate are legally described as: _____
SW of NW less Hwy less N120 ft

Section 20 Township 43 Range 23 Lake _____
PERMIT NO. 46979 Owner Name Wyatt & Cara Bayerle
Address 20810 124th Ln McGrath, Mn 56350
Installer Name Dave's Dirt Work
Type of System Inspected 3 Bdrm Type I Mound
Parcel Number 38-0-031600

The certificate of installation/~~notice of noncompliance~~ was based on No 1 of the following:

- 1) Inspection of the installation or construction as in accordance with the above referenced permit and application design.

- 2) Review of as-built plans submitted in accordance with Subdivision 9.2 D of Aitkin County's Subsurface Sewage Treatment System Ordinance.

If the above permitted subsurface sewage treatment system is in noncompliance with Aitkin County's Subsurface Sewage Treatment System Ordinance, then the following shall serve as a Notice of Violation:

- 1) Statement of the findings of fact through inspections or investigations:

- 2) List of specific violations of Ordinance: _____

- 3) Requirements for correction or removal of violations: _____

- 4) Time schedule for compliance: _____

Failure to correct or remove the above violation(s) will result in this matter being turned over to the Aitkin County Attorney's Office for further legal action, which may result in revocation of licenses, fines and/or imprisonment.

INSPECTOR SIGNATURE _____

K. - - Turlock

Owner Whitt & Cara Bayerle Parcel Number 38-B-03166A
 Project Address 2081A 124th Ln Installer Davis Dirt Work
 City McCrath Zip Code 56752

New Repair

SETBACKS:
 Buildings to tank(s) 34'
 Buildings to drainfield >100'
 Well(s) 50' or 100' 300'
 Lake/Creek/Wetland _____

SEPTIC TANKS: New Existing
 Number of tanks installed 1 Precast combo
 Liquid capacity and type 1000
 Type of baffle Plastic
 Inspection pipes _____
 Manholes size 2 @ 24"
 Manhole to grade Yes No


PUMPS: New Existing
 Tank capacity and type 500 precast
 Pump manufacturer & model # Liberty 283
 Horsepower & GPM 0.5 14 gpm
 Feet of head 29
 Gallons per cycle 125
 Size of discharge line 2"
 Type & location of alarm flac in house
 Water meter _____

DIST. or DROP BOX & TYPE _____
 TRENCHES, BEDS, OR GRAVELLESS LEACHFIELD:
 Trench/Bed depth _____
 Trench/Bed length _____
 Trench/Bed bottom width _____
 Trench spacing _____
 Drainfield rock below pipe _____
 Size of gravelless pipe _____
 Depth of backfill _____
 Absorption area: square feet _____
 lineal feet _____

MOUNDS:
 Percent slope 2
 Upslope sand width 8
 Downslope sand width 18
 Sideslope sand width 8
 Drainfield rock below pipe 9"
 Depth of sand below rock 22
 Perforation size & spacing 1/4 x 3
 Pipe size & spacing 1 1/2 x 3
 Dimensions of rock bed 10 x 38
 Dimensions of sand base 36 x 54
 Final cover 18" Top 12" sides

DRAWING OF SYSTEM: (include soils)

0-8" sand 7.5 us 3/2
 8-18" S.L. 7.5 us 1/4
 12" Redox 7.5 us R 5/2

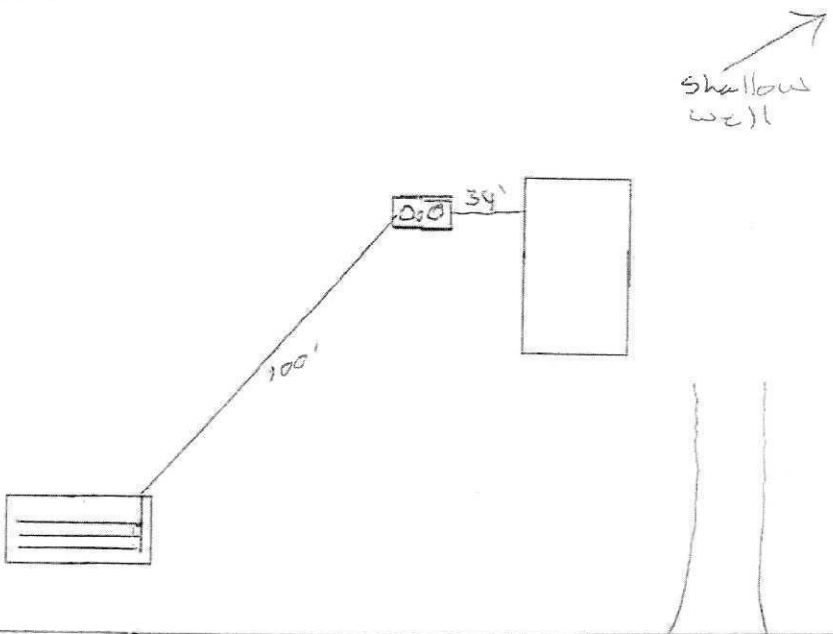

124th Ln

Inspector's Comments:



Map may not be valid at this scale. Data was mapped at an accuracy of 1:24,000 so any representation of the data at a larger scale is not advised.

These data are provided on an "AS-IS" basis, without warranty of any type, expressed or implied, including but not limited to any warranty as to their performance, merchantability, or fitness for any particular purpose.

ArcGIS Web Map



Date: 6/23/2022

Web AppBuilder for ArcGIS

1 inch = 37.6 feet

0 0.0225 0.045 mi

1:4,514