


West

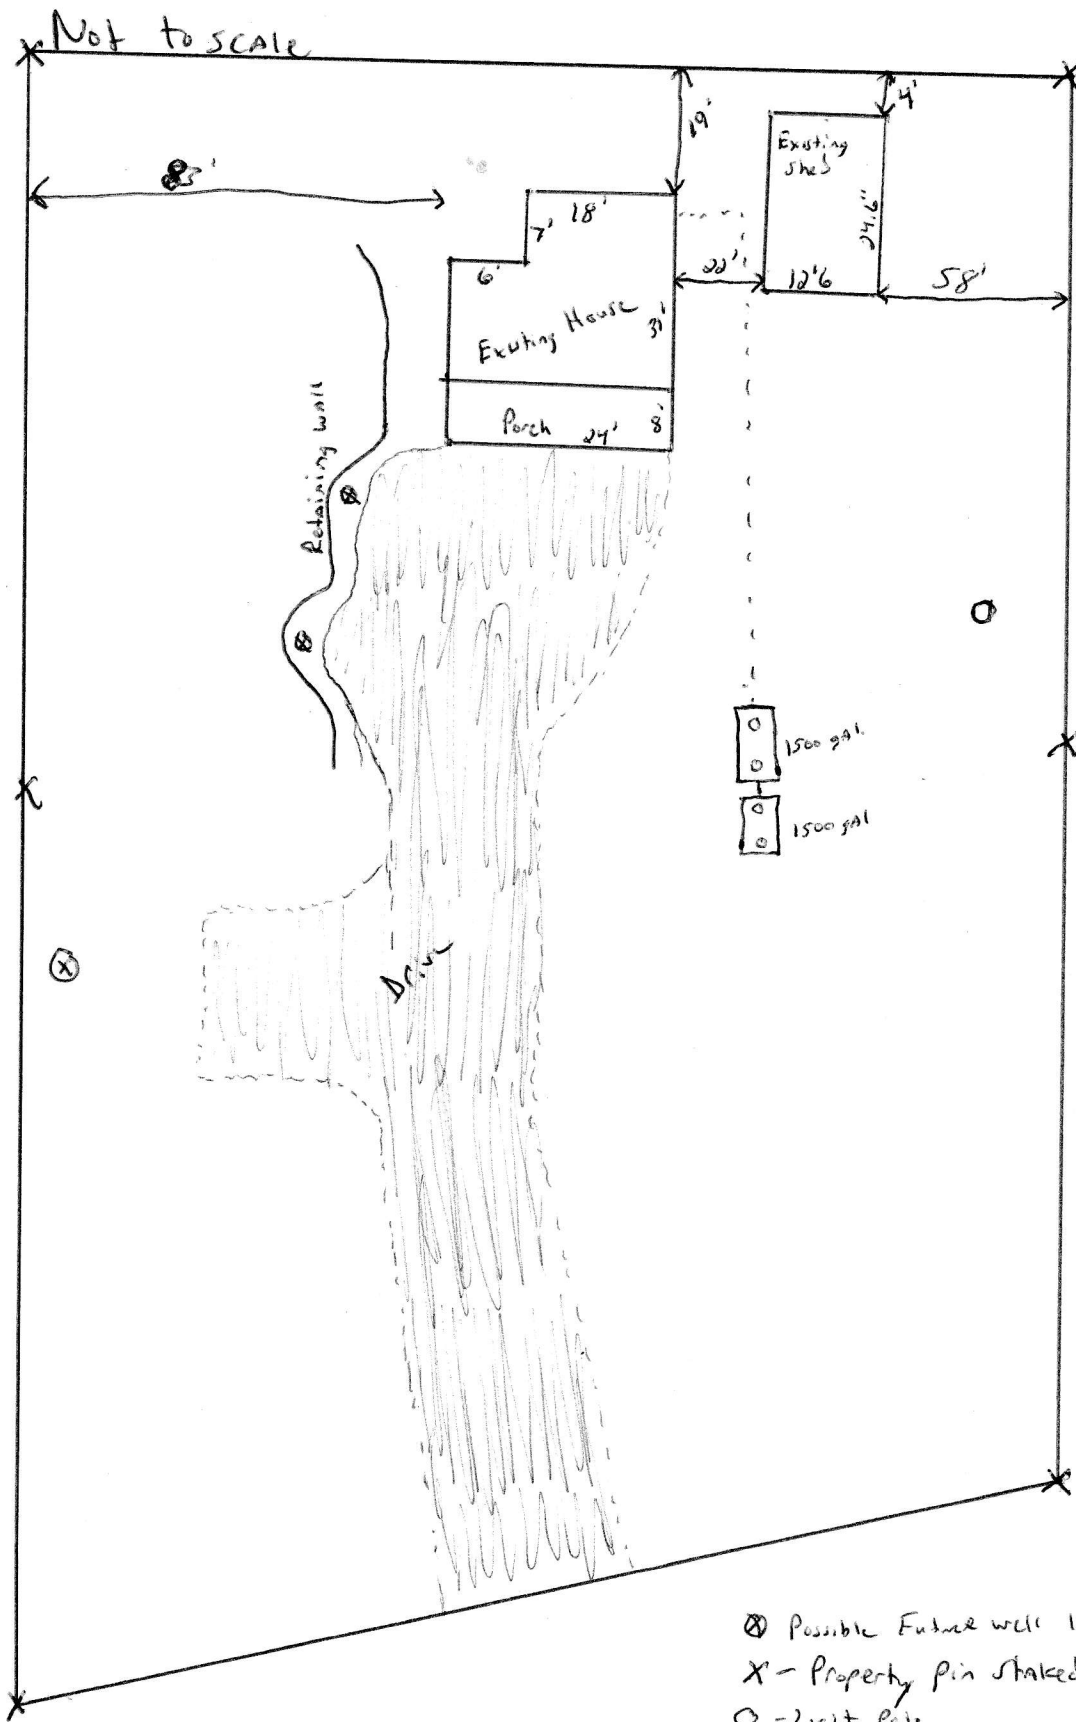

North

- ⊗ Possible Future well location
- X - Property pin staked & Flagged
- - Right Pole
- Proposed sewer line to tanks