


~~32604~~

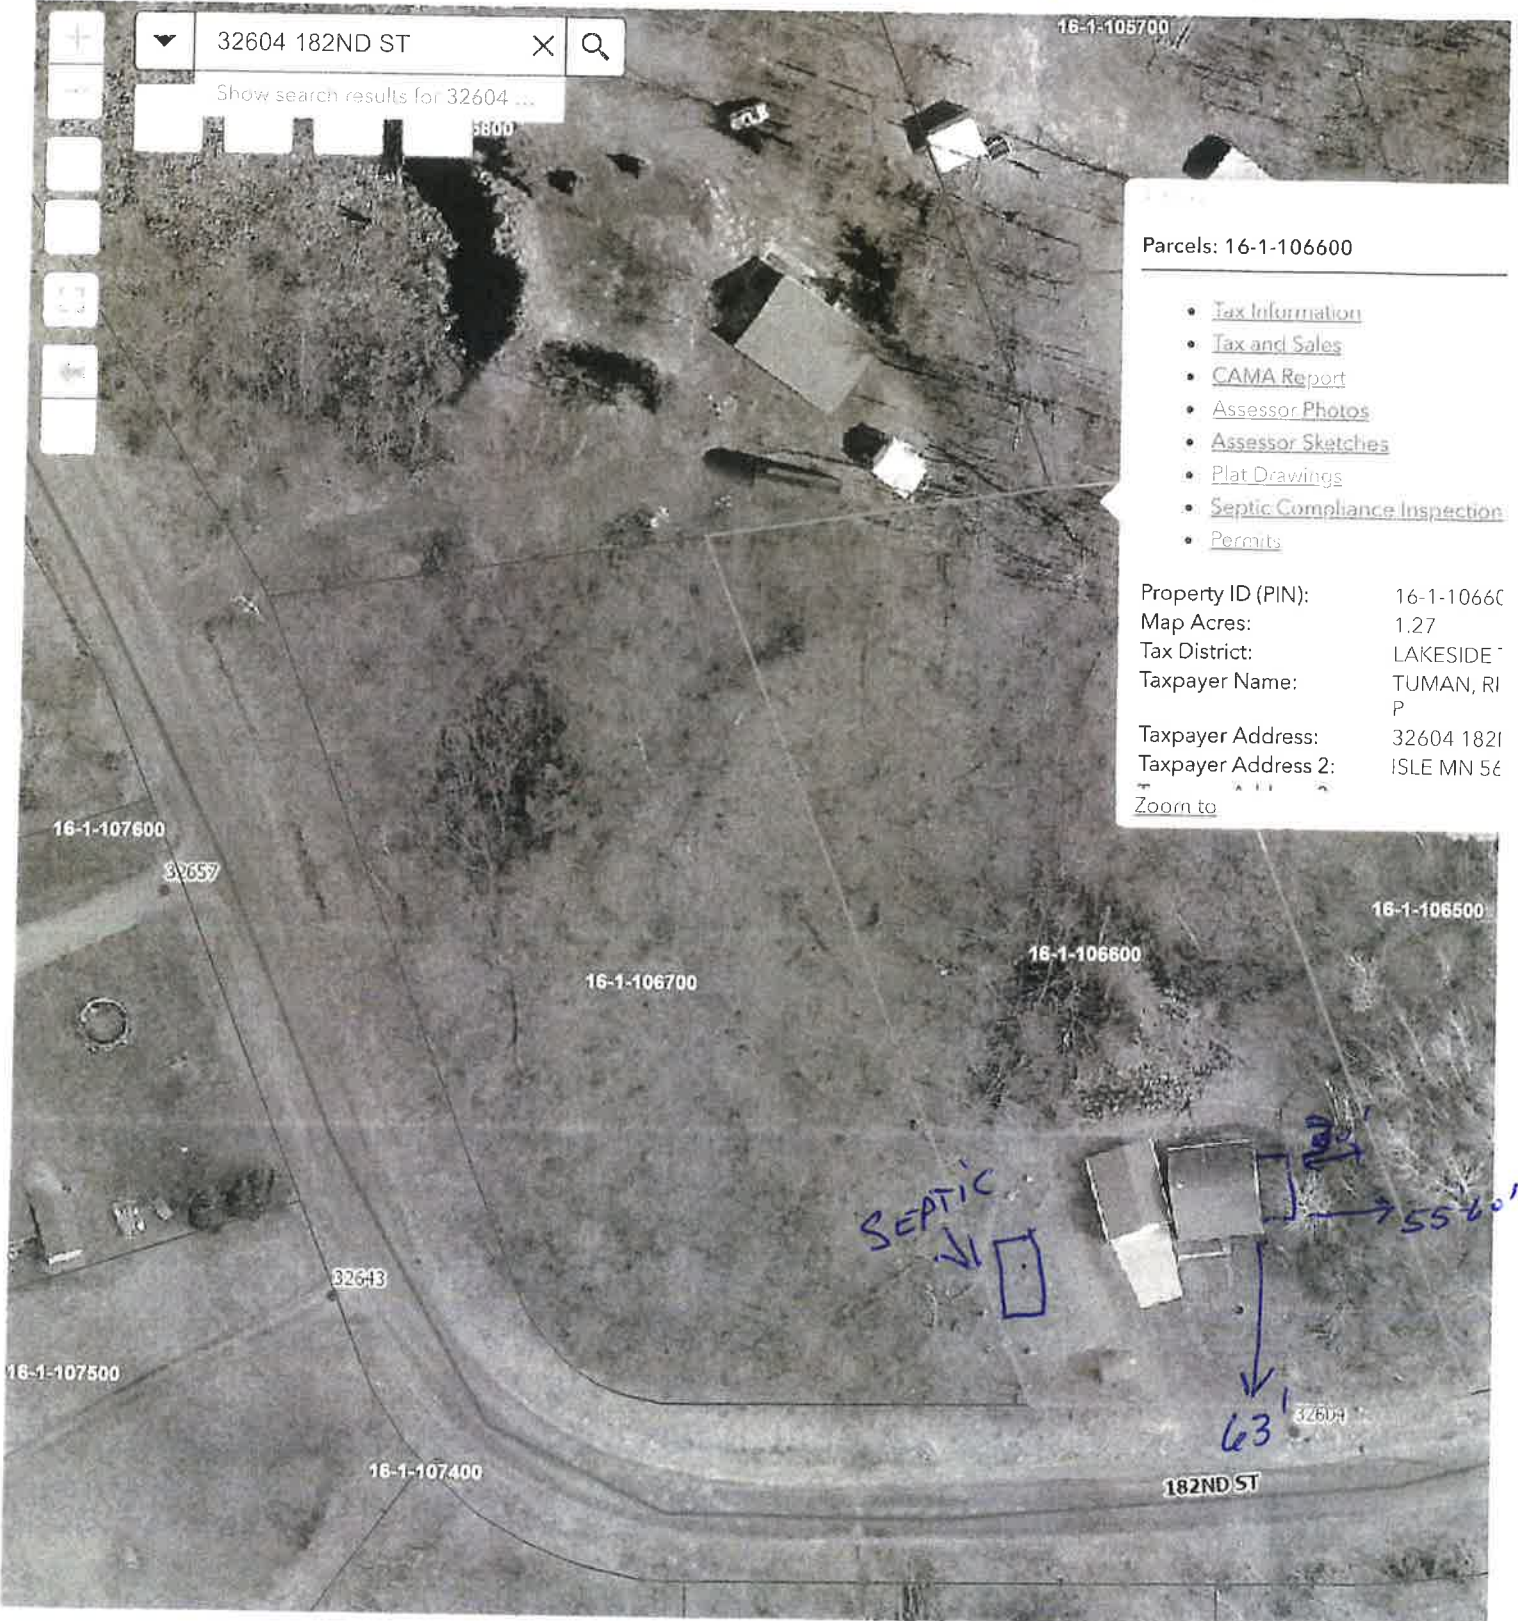

32604 182ND ST X Q

Show search results for 32604 ...

16-1-105700

Parcels: 16-1-106600

- [Tax Information](#)
- [Tax and Sales](#)
- [CAMA Report](#)
- [Assessor Photos](#)
- [Assessor Sketches](#)
- [Plat Drawings](#)
- [Septic Compliance Inspection](#)
- [Permits](#)

Property ID (PIN): 16-1-106600
 Map Acres: 1.27
 Tax District: LAKESIDE
 Taxpayer Name: TUMAN, R
 P
 Taxpayer Address: 32604 182N
 Taxpayer Address 2: ISLE MN 56
 Zoom to

16-1-107600

32657

16-1-106700

16-1-106600

16-1-106600

32643

16-1-107500

16-1-107400

SEPTIC

63'

32604

182ND ST