

**FIELD EVALUATION SHEET**

PRELIMINARY EVALUATION DATE 9-15-22 , FIELD EVALUATION DATE 9-15-22  
PROPERTY OWNER: ERIC DAZLEY PHONE \_\_\_\_\_  
ADDRESS: 32065 DAM LAKE ST CITY, STATE, ZIP: AITKIN MN 56431  
LEGAL DESCRIPTION: E 660 FT OF GOVT LOT 1 LESS HWY  
PIN# 09-0-00701 SEC 5 T 46 R 25 TWP NAME GLEN  
FIRE# \_\_\_\_\_ LAKE/RIVER NONE LAKE CLASS \_\_\_\_\_ OHWL \_\_\_\_\_ FT.

**DESCRIPTION OF SOIL TREATMENT AREAS**

	AREA #1	AREA #2	REFERENCE BM ELEV. <u>100</u> FT
DISTURBED AREAS	YES ___ NO ___	YES ___ NO ___	REFERENCE BM DESCRIPTION _____
COMPACTED AREAS	YES ___ NO ___	YES ___ NO ___	<u>TOP OF SLAB</u>
FLOODING	YES ___ NO ___	YES ___ NO ___	_____
RUN ON POTENTIAL	YES ___ NO ___	YES ___ NO ___	_____
SLOPE %	_____	_____	_____
DIRECTION OF SLOPE	_____	_____	_____
LANDSCAPE POSITION	_____	_____	_____
VEGETATION TYPES	_____	_____	_____

**DEPTH TO STANDING WATER OR MOTTLED SOIL: BORING# 1 6" , 1A 6" , 2 \_\_\_\_\_ , 2A \_\_\_\_\_**

**BOTTOM ELEVATION--FIRST TRENCH OR BOTTOM OF ROCK BED: #1 \_\_\_\_\_ FT., #2 \_\_\_\_\_ FT.**

**SOIL SIZING FACTOR: SITE #1 \_\_\_\_\_ , SITE #2 \_\_\_\_\_**

**CONSTRUCTION RELATED ISSUES: 1650 HOLDING TANK - SITE DOES NOT HAVE 12" OF SOIL FOR A STANDARD SYSTEM**

LIC# 127 SITE EVALUATOR SIGNATURE: Larry Liljenquist

SITE EVALUATOR NAME: LARRY LILJENQUIST TELEPHONE# 218-870-8886

LUG REVIEW \_\_\_\_\_ DATE \_\_\_\_\_

Comments: \_\_\_\_\_  
\_\_\_\_\_  
\_\_\_\_\_

**SOIL BORING LOGS ON REVERSE SIDE**

# SOILS CHARTS FOR BOTH PROPOSED AND ALTERNATE SITES

1 (PROPOSED) SOILS DATA

DEPTH (INCHES)	TEXTURE	MUNSELL COLOR
0-2	T.S.	10YR 3/2
2-13	LOAM FILL	10YR 5/4
13-18	T.S.	10YR 4/2
18-22	LOAM	10YR 5/3

FILL

ALL OTHER LOCATIONS NEXT TO CABIN SHOWING WETLAND VEGETATION

2 (PROPOSED) SOILS DATA

DEPTH (INCHES)	TEXTURE	MUNSELL COLOR
0-2	T.S.	10YR 3/2
2-10		10YR 5/4
10-16	T.S.	10YR 4/2
16-20	LOAM	10YR 5/3

FILL

ALL OTHER LOCATIONS NEXT TO CABIN SHOWING WETLAND VEGETATION

1 (ALTERNATE) SOILS DATA

DEPTH (INCHES)	TEXTURE	MUNSELL COLOR

2 (ALTERNATE) SOILS DATA

DEPTH (INCHES)	TEXTURE	MUNSELL COLOR


ADDITIONAL SOIL BORINGS MAY BE REQUIRED

**SKETCH SHEET**

CLIENT: ERIC DAZLEY

DATE: 9-15-22

MAP DRAWN TO SCALE WITH A NORTH ARROW

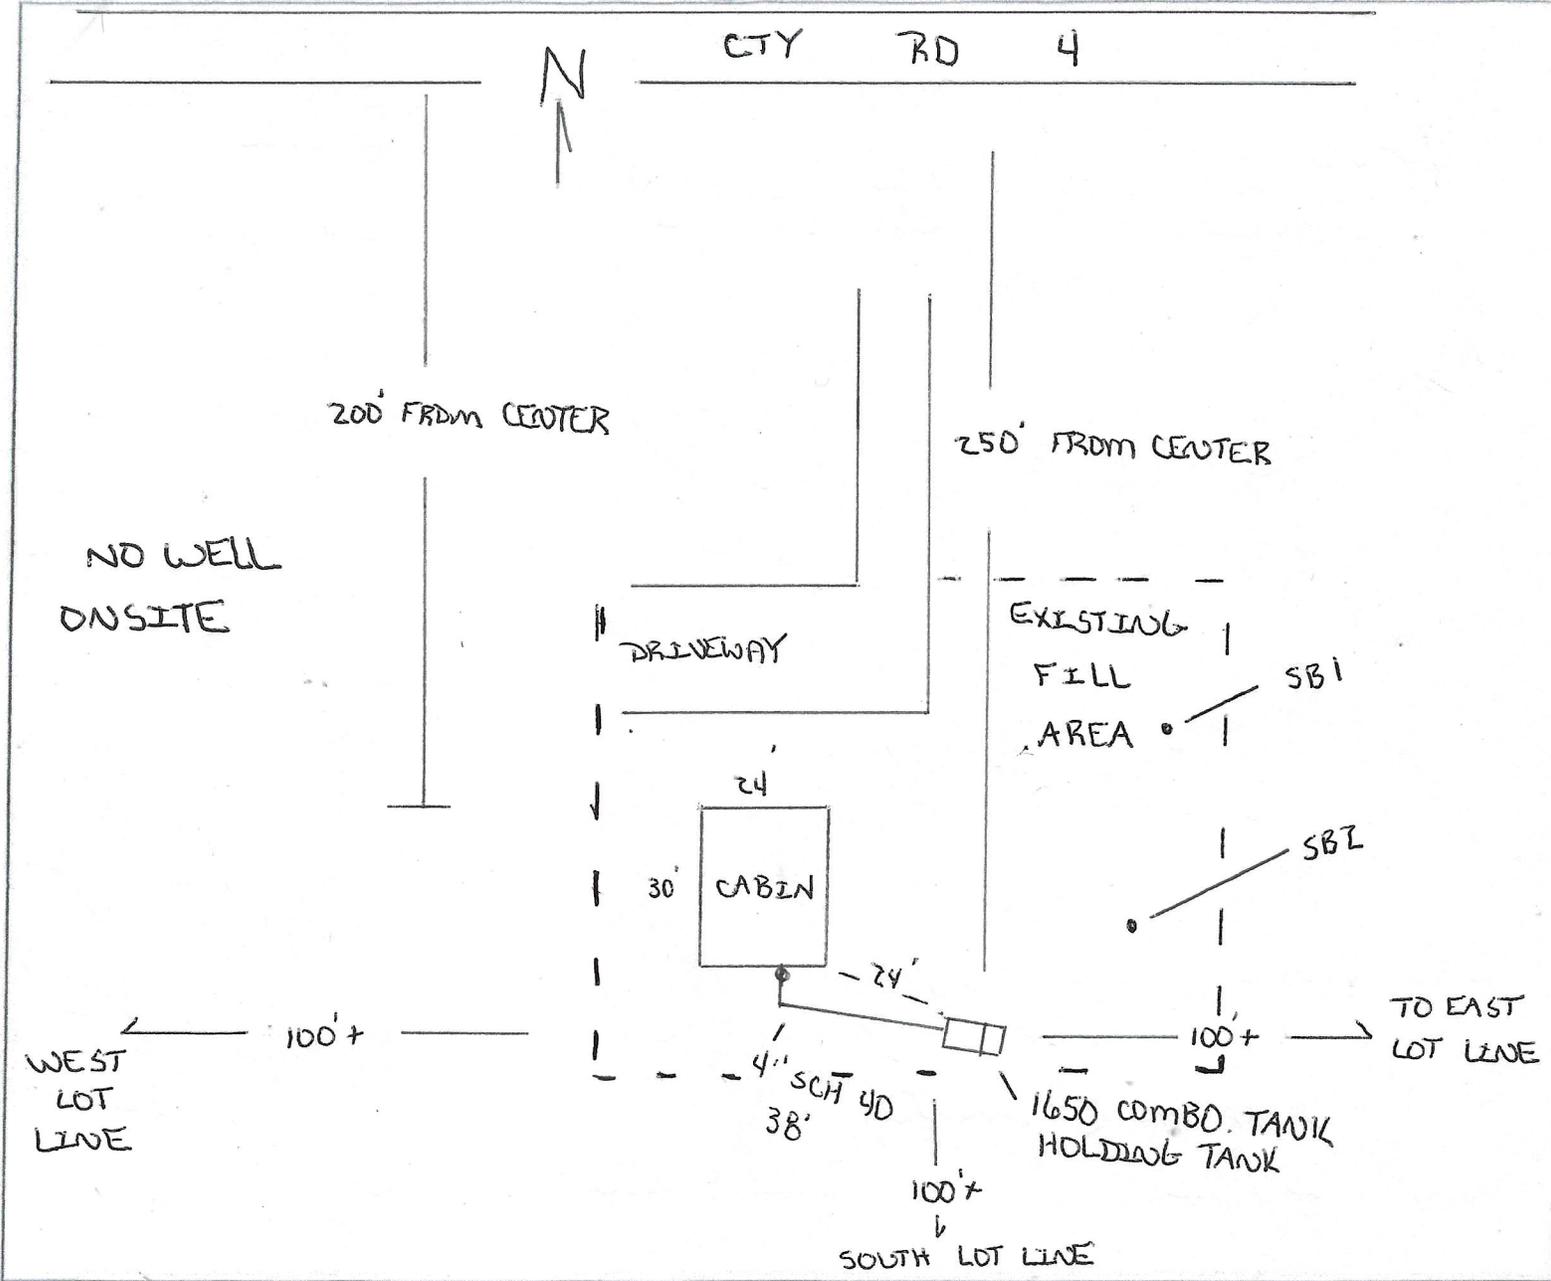

**CHECK OFF LIST--HAVE ALL OF THE FOLLOWING BEEN DRAWN ON THE MAP??**

**SHOW EXISTING OR PROPOSED**

- WATER WELLS WITHIN 100 FT OF TREATMENT AREAS
- PRESSURE WATER LINES WITHIN 10 FT OF TREATMENT AREAS
- STRUCTURES
- ALL SOIL TREATMENT AREAS
- HORIZONTAL AND VERTICAL REFERENCE
- POINT OF SOIL BORINGS
- LOT EASEMENTS
- DISTURBED/ COMPACTED AREAS
- SITE PROTECTION--LATHE AND RIBBON EVERY 15 FT
- ACCESS ROUTE FOR TANK MAINTENANCE
- LOT IMPROVEMENTS
- ALL ISTS COMPONENTS
- DIRECTION OF SLOPE
- ALL LOT DIMENSIONS

**REQUIRED SETBACKS**

- STRUCTURES
- OHWL
- PROPERTY LINES

COMMENTS:

**INDICATE ELEVATIONS**

- BENCHMARK 100 - TOP OF SLAB
- ELEVATION OF SEWER LINE @ HOUSE 98.5
- ELEVATION @ TANK INLET 97.5
- ELEVATION @ BOTTOM OF ROCK LAYER
- ELEVATION @ BOTTOM OF BORING OR RESTRICTIVE LAYER
- ELEVATION OF PUMP
- ELEVATION OF DISTRIBUTION DEVICE

DESIGNER SIGNATURE Larry Lyngstad  
 LICENSE# 127

DATE 9-15-22

HOLDING TANK PUMPING SERVICE AGREEMENT

Permit # \_\_\_\_\_ Address \_\_\_\_\_

THIS AGREEMENT, entered into by and between Aitkin County Registered Septic Tank Pumper, \_\_\_\_\_, hereinafter referred to as "Contractor", and \_\_\_\_\_, hereinafter referred to as "Homeowner".

WHEREAS, Homeowner desires and is required to retain individual sewage treatment system holding tank services to protect the environment and to obtain a certificate of compliance from Aitkin County; and

WHEREAS, the Contractor desires to provide sewage treatment system pumping services to Homeowner as necessary and in accordance with the terms and conditions outlined herein.

NOW THEREFORE, in consideration of the mutual promises contained herein, Parties do hereby agree as follows:

1. **TERM.** The term of this Agreement shall be from \_\_\_\_\_ to final installation of an Aitkin County approved sewage treatment system or connection to a Municipal Sewage Treatment System, unless earlier terminated as provided herein. The parties understand and agree that this Agreement is intended to arrange for the provision of pumping services so that Homeowner may occupy the home pursuant to a certificate of compliance to be issued by the Aitkin County Environmental Services Department upon execution of this Agreement. Homeowner further agrees that at the earliest possible date, Homeowner shall have a permanent sewage treatment system installed in accordance with the Aitkin County Subsurface Sewage Treatment System Ordinance and as approved by the Aitkin County Environmental Services Department or connect to a Municipal Sewage Treatment System. Upon approval by the County of Aitkin of the individual sewage treatment system or connection to a municipal sewer, or approval by Aitkin County Environmental Services of an amended or different contract, this Agreement shall terminate.


2. **FREQUENCY OF PUMPING.** Homeowner agrees that he/she shall not allow the holding tank to overflow or discharge in any manner. Contractor and Homeowner agree that the holding tank shall be pumped in accordance with the following:

- Tank size (gal.) \_\_\_\_\_ / (number of household occupants multiplied by 75 gallons per day) = frequency of pumping; or
- Within 24 hours of indication by tank alarm of lack of capacity (applicable only if system has a functional alarm):
- Whichever is greater

Contractor agrees to provide pumping services according to the regular pumping schedule or as needed to prevent discharge. Homeowner shall compensate Contractor as agreed by the parties for pumping services rendered.

3. **INSPECTION.** Holding tanks will be inspected by a licensed pumper at the time of servicing for leaks below the operating depth and whether tank tops, riser joints, and connections leak through visual evidence of major defects.

4. **REPORTING.** Grievances of Homeowner or Contractor shall be reported to the Aitkin County Environmental Services Department by Homeowner or Contractor. Homeowner and Contractor understand that failure to have holding tank pumped as herein specified or the discharge of any contents from the holding tank, regardless of fault, may result in the suspension, cancellation or revocation of the certificate of compliance, and the homeowner may be required to vacate the premises.

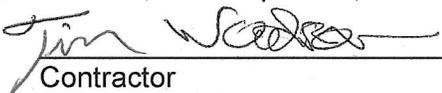  
Contractor

\_\_\_\_\_  
Homeowner

Date 9-10-22

Date \_\_\_\_\_