


SKETCH SHEET

CLIENT: _____

DATE: _____

MAP DRAWN TO SCALE ~~1"=100'~~ WITH A NORTH ARROW

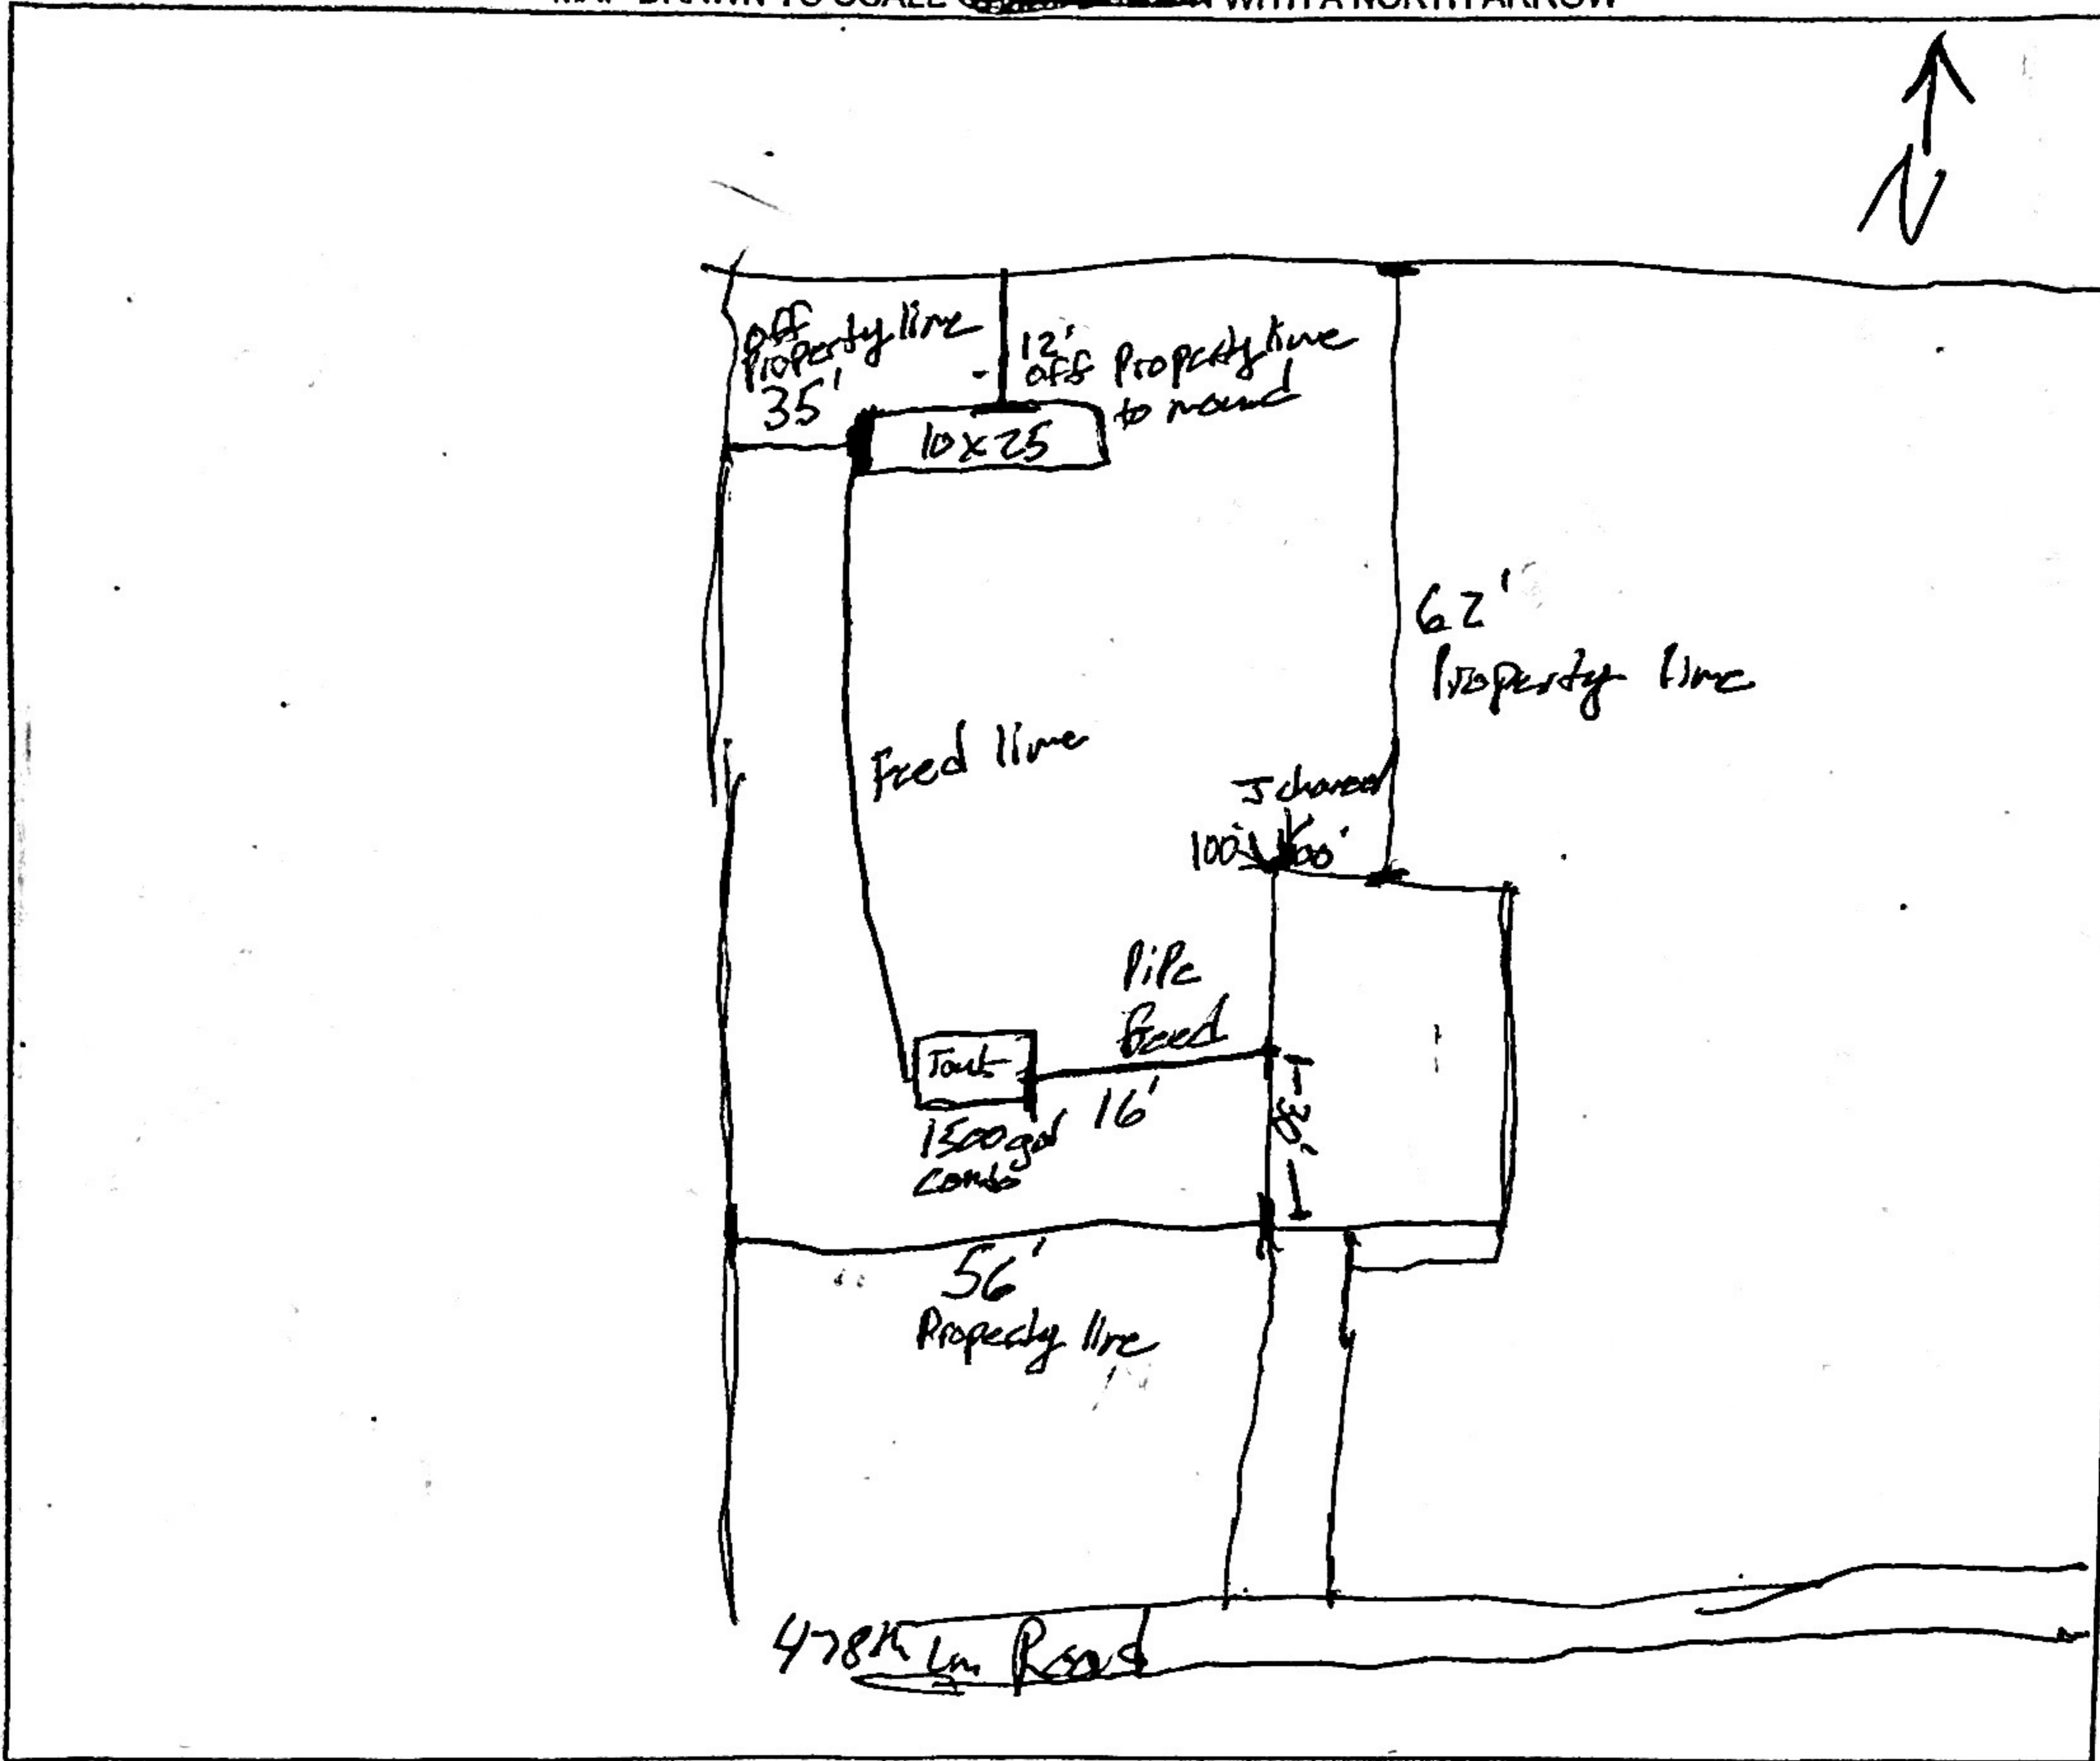

CHECK OFF LIST--HAVE ALL OF THE FOLLOWING BEEN DRAWN ON THE MAP??

SHOW EXISTING OR PROPOSED

- WATER WELLS WITHIN 100 FT OF TREATMENT AREAS
- PRESSURE WATER LINES WITHIN 10 FT OF TREATMENT AREAS
- STRUCTURES LOT IMPROVEMENTS
- ALL SOIL TREATMENT AREAS ALL ISTS COMPONENTS
- HORIZONTAL AND VERTICAL REFERENCE
- POINT OF SOIL BORINGS DIRECTION OF SLOPE
- LOT EASEMENTS ALL LOT DIMENSIONS
- DISTURBED/ COMPACTED AREAS
- SITE PROTECTION--LATHE AND RIBBON EVERY 15 FT
- ACCESS ROUTE FOR TANK MAINTENANCE

REQUIRED SETBACKS

- STRUCTURES PROPERTY LINES
- OHWL

COMMENTS:

DESIGNER SIGNATURE _____
 LICENSE# _____

INDICATE ELEVATIONS

BENCHMARK 100' 98.25
 ELEVATION OF SEWER LINE @ HOUSE ~~98.25~~
 ELEVATION @ TANK INLET 97.6
 ELEVATION @ BOTTOM OF ROCK LAYER 98.4
 ELEVATION @ BOTTOM OF BORING OR RESTRICTIVE LAYER 96
 ELEVATION OF PUMP _____
 ELEVATION OF DISTRIBUTION DEVICE _____

DATE _____