

UNIVERSITY  
OF MINNESOTA

OSTP As-Built Form



Owner: Barry L Nichol Arcand Parcel Number: 0-2-0-013800

Street/City/Zip Code: Hwy 200; Jacobson, Minn 55752

Lot: 4 Section: 7 Township: 57 N Range: 23 W

Installation Date: Fall/Summer 2013 Installer: Barry Arcand License Number: None

Is the system in Shoreland, serving a MDH facility or in a Wellhead Protection area?  YES  NO

Number of Bedrooms/ Flow Rate: OUT house #/gpd Septic Tanks, No & Size: 1 540 #/gal

Pump Tank Size: None gal Tank Manufacturer: 1 Compartment Infiltrator

Pump Size: None hp   gpm   ft of TDH Floats properly set?  YES  NO

Soil Treatment Area:

TYPE I  TYPE II  TYPE III  TYPE IV  TYPE V

TRENCH  BED  MOUND  AT-GRADE  WARRANTIED  OTHER: outhouse / to be pump

Limiting Layer/Depth: N/A" Rockbed Size: N/A Describe: None will install

manually

Depth from Surface: N/A" Adsorption Width: N/A

Media or Slat depth: N/A" Sand Depth: N/A

Trench Width: N/A ft (under mound)

Bottom Square Feet Area: N/A ft<sup>2</sup>

Design Variances: N/A

#### Other Information:

List any further system descriptions:

Site  
• See drawing

List any material testing results (jar test, sieve analysis, etc):

N/A

List conditions during construction:

UNKNOWN

List who is responsible for establishing vegetative cover:

Owner - Barry Arcand

I hereby certify that I have completed this work in accordance with applicable ordinances, rules, and laws.

Harry Holmgren (Installer) E 1016 (license #) 12-12-22 (Date)


Harry Holmgren

INSPECTOR

## Site Drawing:

### Items to be Identified:

1. Septic, holding and pump tanks, piping, and soil system configuration. Label bed or trench width and length or rockbed size, absorption on width and final dimensions. Indicate alarm location. TO be INSTALLED - Manual - float
2. Show all setbacks from tank and soil system including:  
A. Property boundaries B. Buildings C. Wells D. Water bodies E. Road right-of-way (NO WELL)
3. Improvements - present and future ?
4. Benchmark location and distance of tank and soil system from benchmark N/A
5. Replacement site N/A
6. Abandon system N/A

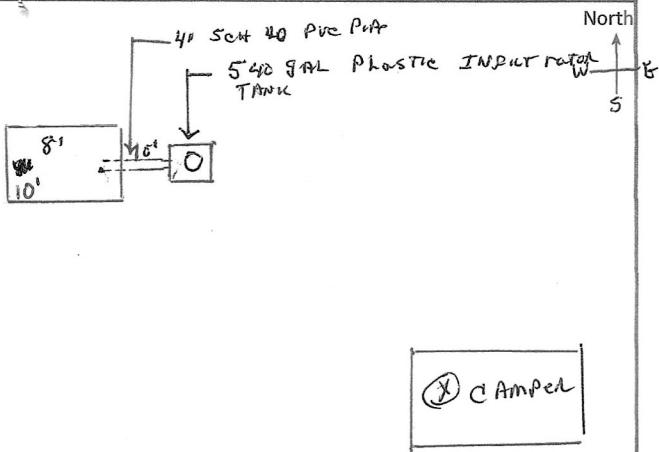

NOTE: OUT house NOT built AS OF yet (12-12-2022)  
Floor

NOTE: 8x10 OUT house APPROX 18" Above ground

NOTE: NO WELL INSTALLED Yet

NOTE: WILL be a water FLUSH TOILET (Summer use ONLY)

NOTE: NOT TO SCALE