

# FARLEY SEWER SYSTEMS


SEWER DESIGN & INSTALLATION

JAROLD R. FARLEY

P.O. Box 472  
McGregor, MN 55760

Bus. Lic. No. L1919  
Reg. No. 4741

218-624-4727 cell

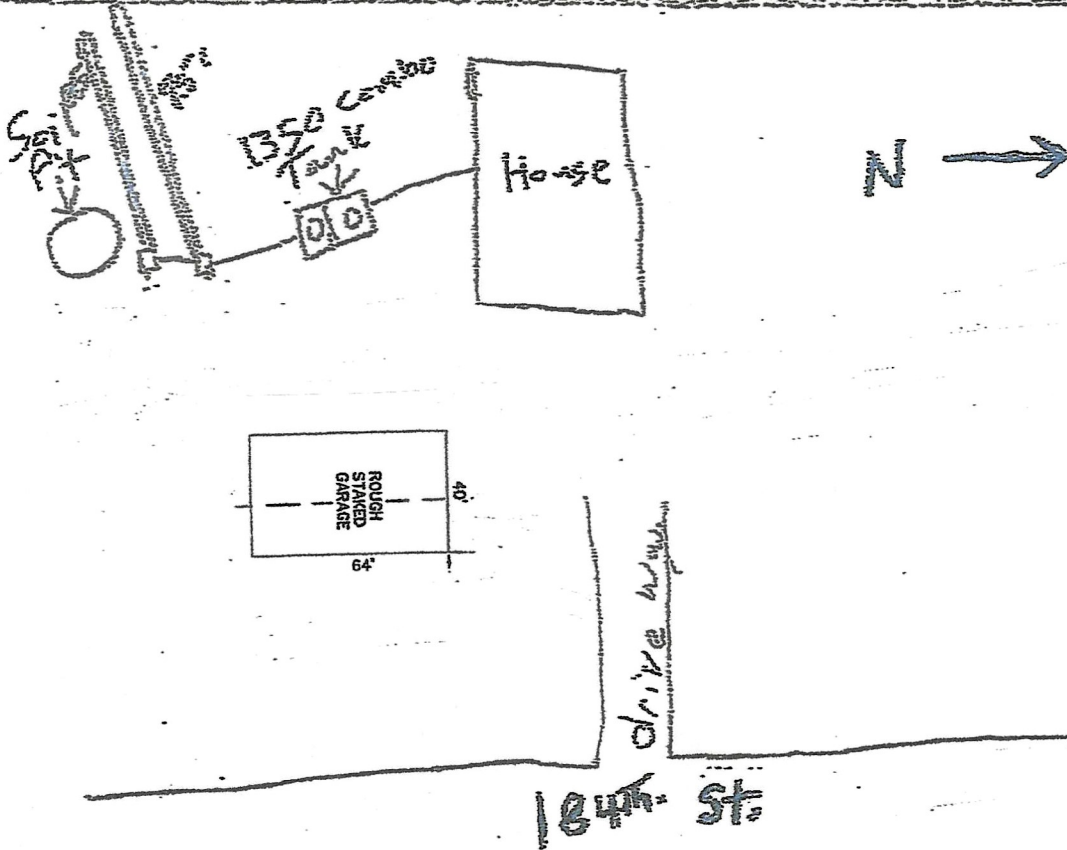

## Soil Boring Info:

0-5"	Top Soil	10 yR 3/2
5-64"	Sandy Loam	10 yR 4/6