


SURVEY FOR: BRYON ANDERSON  
1903 WEST MARK STREET  
WINONA, MN 55987

SURVEY OF: LOT 9, BLOCK 2 AND PART OF THE  
ADJACENT VACATED ROADWAY OF  
THE RECORDED PLAT OF "ALLIE'S  
DUCK PASS" LOCATED IN SECTION  
11, TOWNSHIP 46, RANGE 26,  
AITKIN COUNTY, MINNESOTA.

**STRAIGHTLINE SURVEYING, INC.**

P.O. Box 510, 500 Folz Blvd Telephone: (218)-485-4811  
Moose Lake, MN 55767 Fax: (218)-485-4811  
E-MAIL: bonderson@straightlinesurveying.com

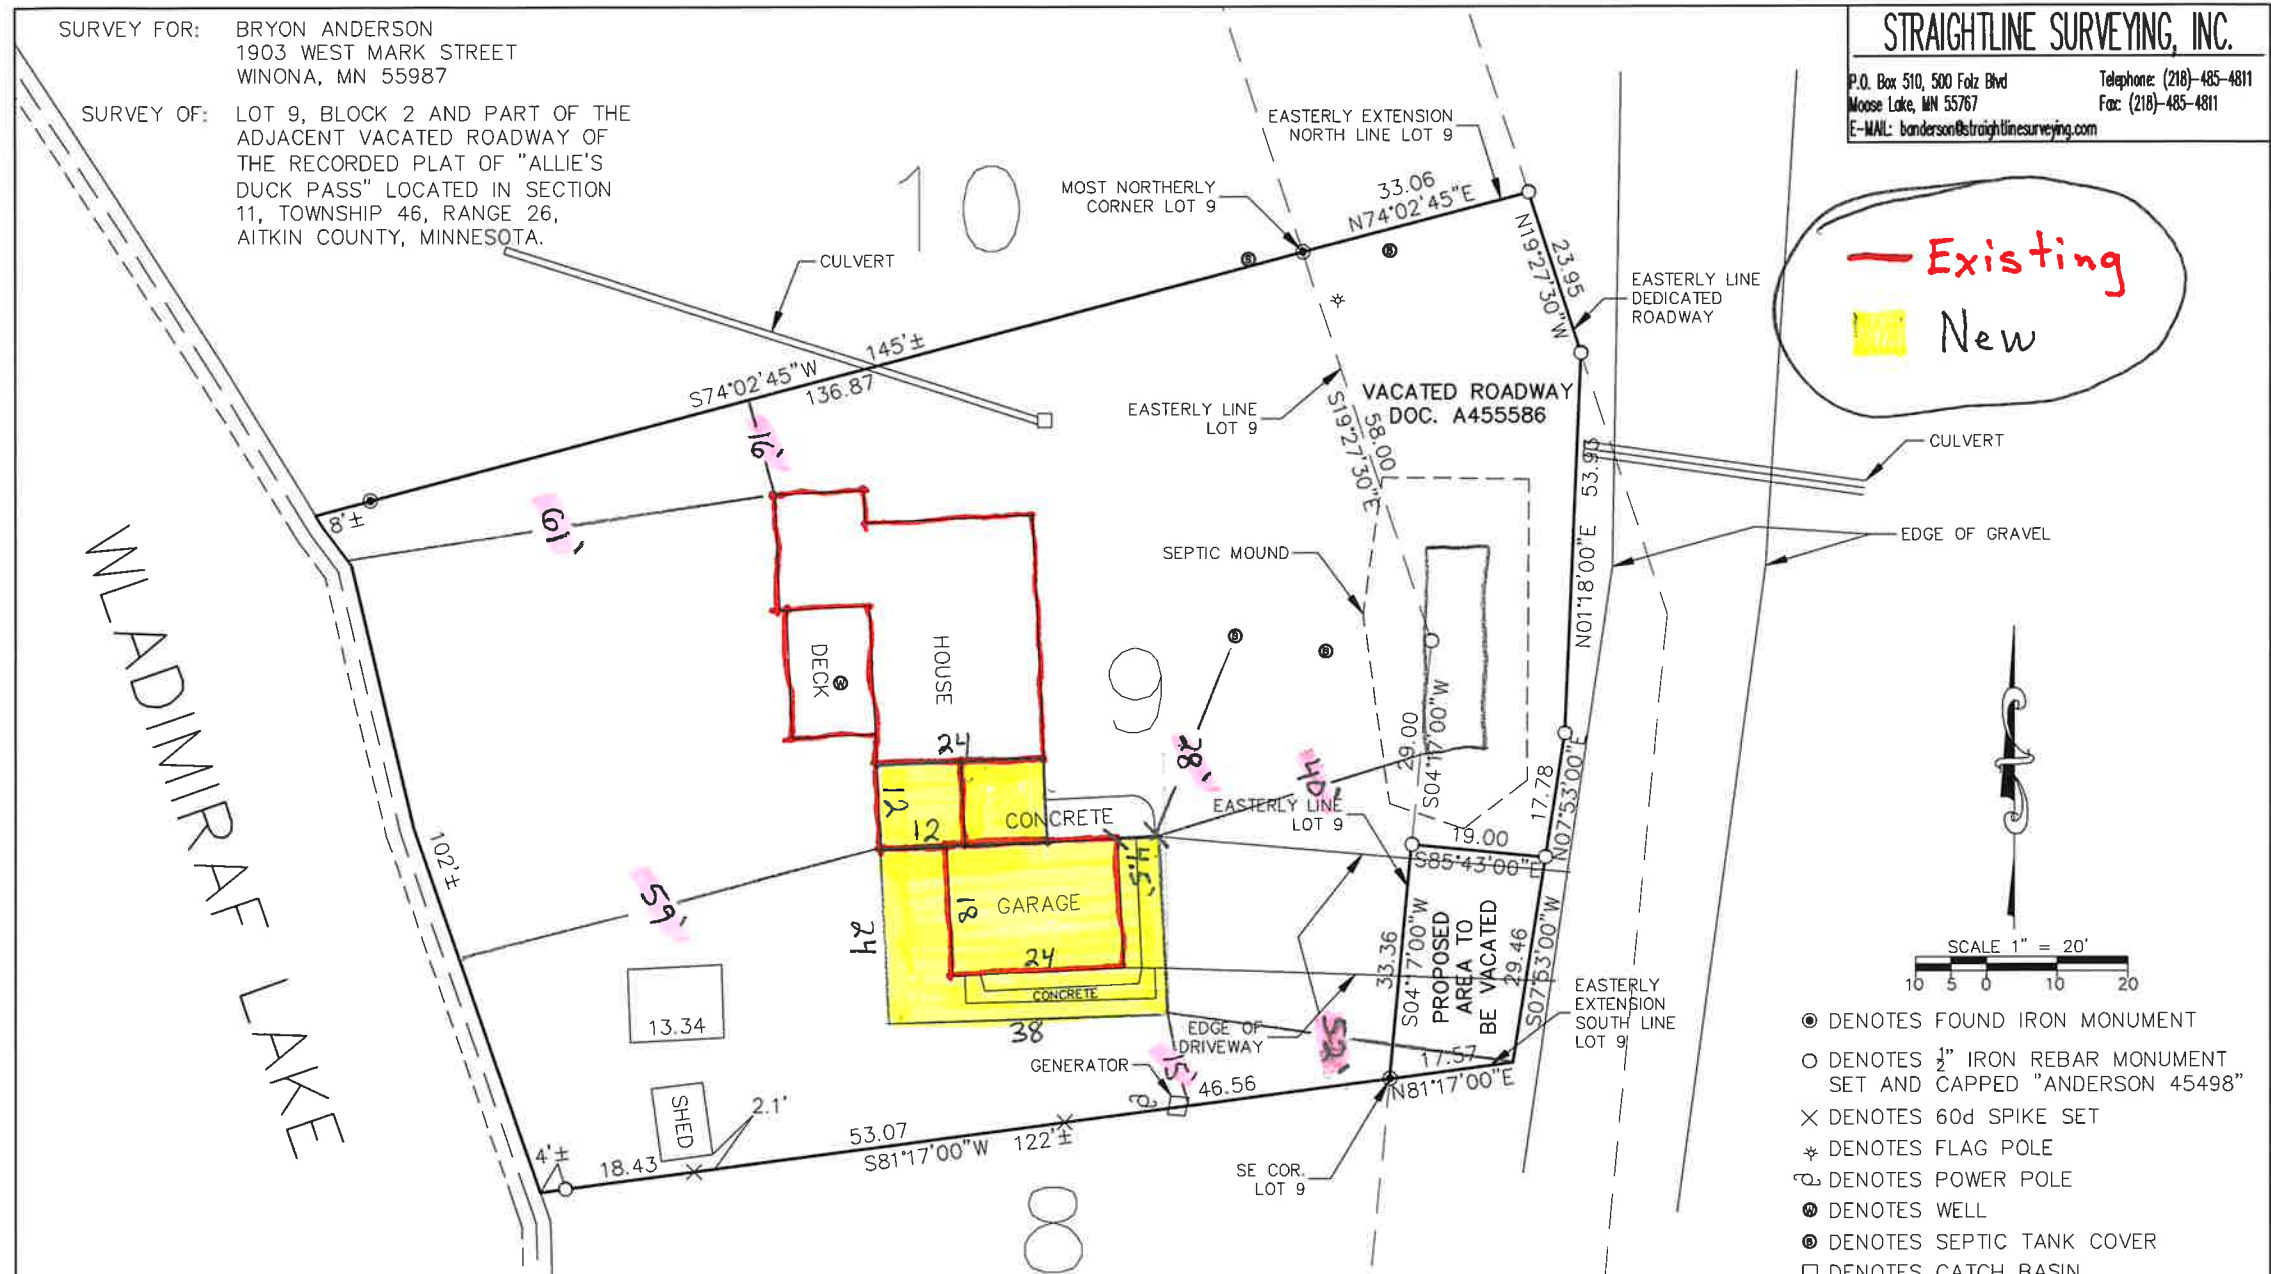

**Existing**  
**New**



- ⊙ DENOTES FOUND IRON MONUMENT
- DENOTES 1/2" IRON REBAR MONUMENT SET AND CAPPED "ANDERSON 45498"
- × DENOTES 60d SPIKE SET
- \* DENOTES FLAG POLE
- ⊕ DENOTES POWER POLE
- ⊗ DENOTES WELL
- ⊙ DENOTES SEPTIC TANK COVER
- DENOTES CATCH BASIN

I hereby certify that this survey, plan, or report was prepared by me or under my direct supervision and that I am a duly Licensed Land Surveyor under the laws of the State of Minnesota.

*Benjamin H. Anderson*  
Benjamin H. Anderson

45498  
License No.

08-10-2023  
Date

2023-121  
Job No.

AITKIN 3 P.44  
Book No.