

AITKIN COUNTY
CERTIFICATE OF INSTALLATION/~~NOTICE OF NONCOMPLIANCE~~

This certificate of installation/~~notice of noncompliance~~ has been issued this _____ day of _____, 20____ to certify compliance/~~noncompliance~~ with Aitkin County's Subsurface Sewage Treatment System Ordinance.

The premises covered by this certificate are legally described as: _____

Section _____ Township _____ Range _____ Lake _____
PERMIT NO. _____ Owner Name _____
Address _____
Installer Name _____
Type of System Inspected _____
Parcel Number _____

The certificate of installation/~~notice of noncompliance~~ was based on No ___ of the following:

- 1) Inspection of the installation or construction as in accordance with the above referenced permit and application design.

- 2) Review of as-built plans submitted in accordance with Subdivision 9.2 D of Aitkin County's Subsurface Sewage Treatment System Ordinance.

If the above permitted subsurface sewage treatment system is in noncompliance with Aitkin County's Subsurface Sewage Treatment System Ordinance, then the following shall serve as a Notice of Violation:

1) Statement of the findings of fact through inspections or investigations:

2) List of specific violations of Ordinance: _____

3) Requirements for correction or removal of violations: _____

4) Time schedule for compliance: _____

Failure to correct or remove the above violation(s) will result in this matter being turned over to the Aitkin County Attorney's Office for further legal action, which may result in revocation of licenses or registrations, fines and/or imprisonment.

INSPECTOR SIGNATURE _____

**SUBSURFACE SEWAGE TREATMENT SYSTEM INSPECTION FORM
AITKIN COUNTY, MINNESOTA**

2023-0250

Township Farm Island Date of Inspection 6/5/2023 App. Number 47671

Owner Jason + Amy Michael Parcel Number 07-1-096700

Project Address 29236 412th Pl. Installer Ritter EXL.

City Aitkin Zip Code 56431 T2 HT

New Repair

DIST. or DROP BOX & TYPE —

SETBACKS:

Buildings to tank(s) 10'+

Buildings to drainfield —

Well(s) 50' or 100' DW: 50'+

Lake/Creek/Wetland Spirit Lake: 100'+

TRENCHES, BEDS, OR GRAVELLESS LEACHFIELD:

Trench/Bed depth —

Trench/Bed length —

Trench/Bed bottom width —

Trench spacing —

Drainfield rock below pipe —

Size of gravelless pipe —

Depth of backfill —

Absorption area: square feet —

lineal feet —

SEPTIC TANKS: New Existing

Number of tanks installed 1

Liquid capacity and type 1820 gal. combs

Type of baffle Plastic

Inspection pipes —

Manholes size 24"

Manhole to grade Yes No

MOUNDS:

Percent slope —

Upslope sand width —

Downslope sand width —

Sideslope sand width —

Drainfield rock below pipe —

Depth of sand below rock —

Perforation size & spacing —

Pipe size & spacing —

Dimensions of rock bed —

Dimensions of sand base —

Final cover —

PUMPS: New Existing

Tank capacity and type —

Pump manufacturer & model # —

Horsepower & GPM —

Feet of head —


Gallons per cycle —

Size of discharge line —

Type & location of alarm Manual popup

Water meter —

DRAWING OF SYSTEM: (include soils)

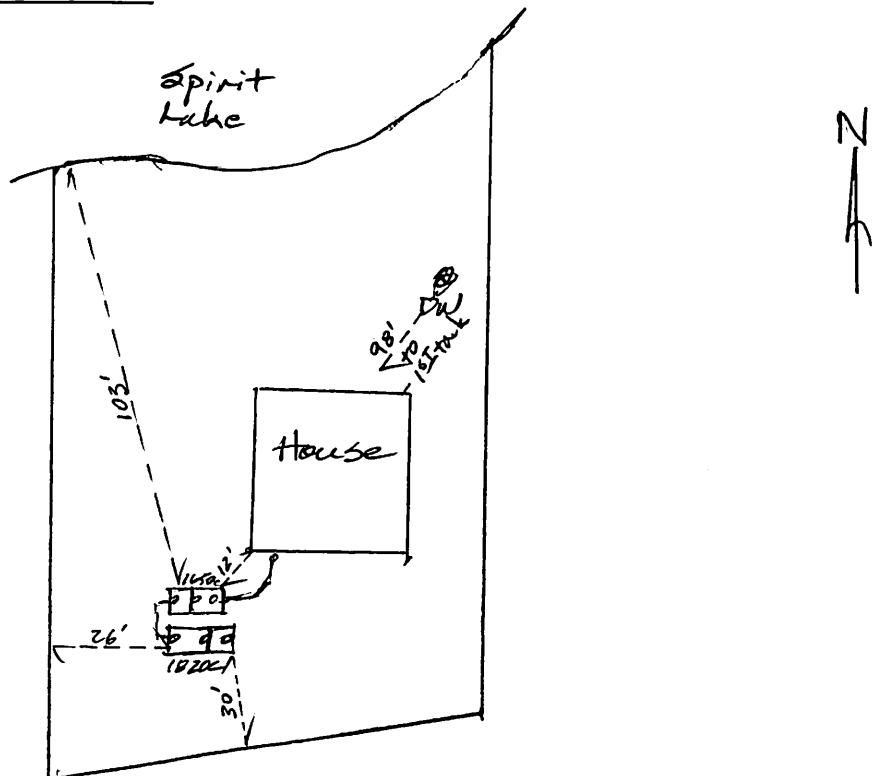

Inspector's Comments: There is an existing 1650 HT on site. 1820c added to the tankage.

Inspector's Signature B. Hargrave Installer's Signature B. Ritter 1698





