
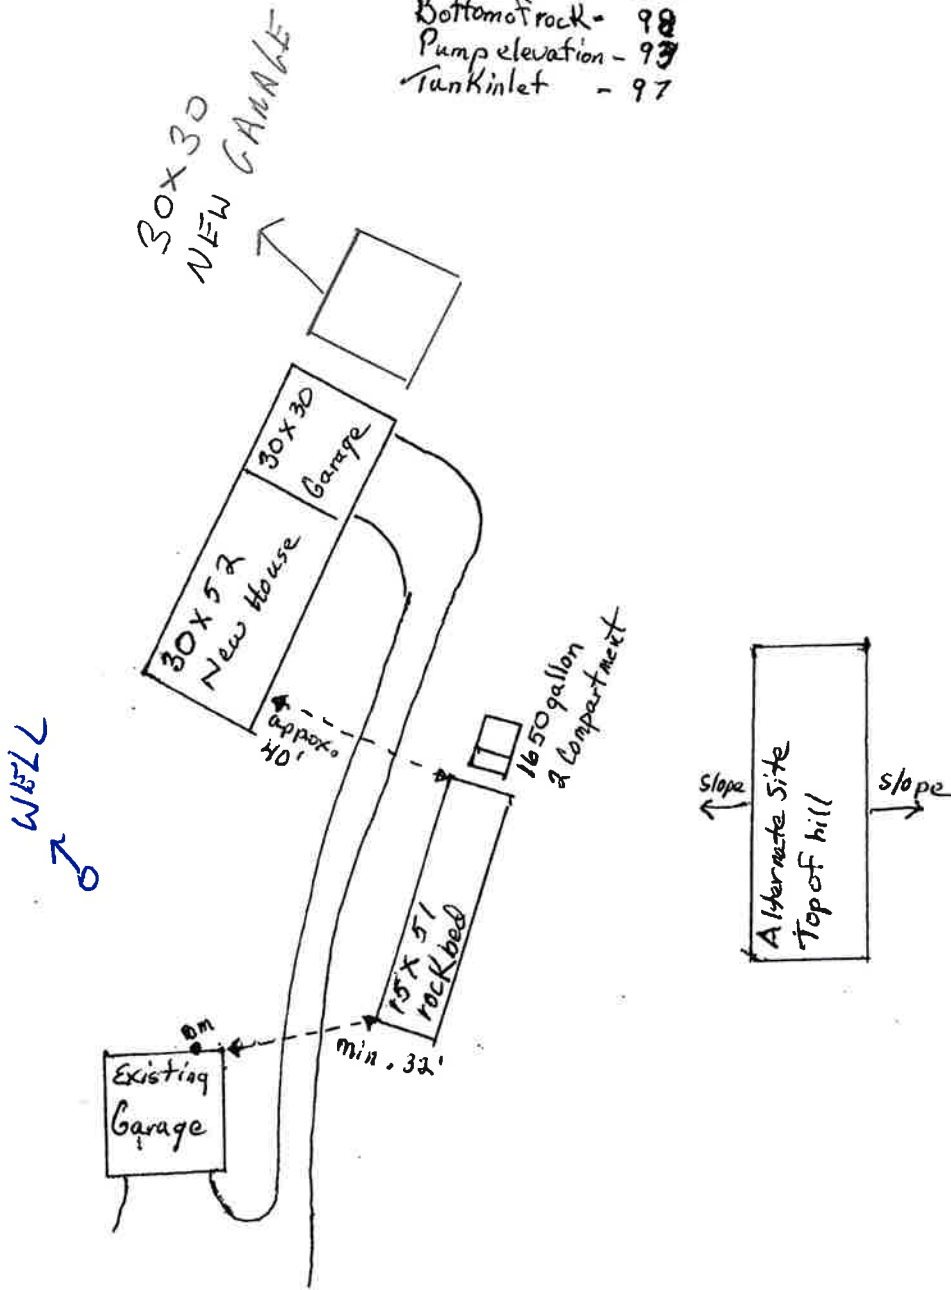


Approximate Elevations:

Bench mark - 100
 Bottom of rock - 98
 Pump elevation - 97
 Tank inlet - 97

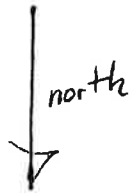

(97) 5-21-21