

AITKIN COUNTY
CERTIFICATE OF INSTALLATION/~~NOTICE OF NONCOMPLIANCE~~

This certificate of installation/~~notice of noncompliance~~ has been issued this 8th day of August, 2023 to certify compliance/~~noncompliance~~ with Aitkin County's Subsurface Sewage Treatment System Ordinance.

The premises covered by this certificate are legally described as: SE-NE

Section 31 Township 51 Range 24 Lake _____
PERMIT NO. 48046 Owner Name Steven & Lynn Weston
Address 58497 270th Ave Palisade, Mn 56469
Installer Name Kern Excavating
Type of System Inspected 2 Bdrm Type III Mound
Parcel Number 33-0-048700

The certificate of installation/~~notice of noncompliance~~ was based on No 1 of the following:

- 1) Inspection of the installation or construction as in accordance with the above referenced permit and application design.

- 2) Review of as-built plans submitted in accordance with Subdivision 9.2 D of Aitkin County's Subsurface Sewage Treatment System Ordinance.

If the above permitted subsurface sewage treatment system is in noncompliance with Aitkin County's Subsurface Sewage Treatment System Ordinance, then the following shall serve as a Notice of Violation:

- 1) Statement of the findings of fact through inspections or investigations:

- 2) List of specific violations of Ordinance: _____

- 3) Requirements for correction or removal of violations: _____

- 4) Time schedule for compliance: _____

Failure to correct or remove the above violation(s) will result in this matter being turned over to the Aitkin County Attorney's Office for further legal action, which may result in revocation of licenses, fines and/or imprisonment.

INSPECTOR SIGNATURE



**SUBSURFACE SEWAGE TREATMENT SYSTEM INSPECTION FORM
AITKIN COUNTY, MINNESOTA**

Township Varden Date of Inspection 8-8-23 Final App. Number 2023-000227
 Owner Sarah Weston Parcel Number 33-A-048700
 Project Address 58497 270th Ave Installer Keen Excavating
 City Puliscuda Zip Code 56469

New Repair

SETBACKS:

Buildings to tank(s) 38'
 Buildings to drainfield 38'
 Well(s) 50' or 100' 25'
 Lake/Creek/Wetland _____

SEPTIC TANKS: New Existing _____
 Number of tanks installed 1 1650 Jacobson
 Liquid capacity and type 1120 Precast
 Type of baffle Plastic
 Inspection pipes _____
 Manholes size 2 @ 24 1 @ 20
 Manhole to grade Yes No _____

PUMPS: New Existing _____
 Tank capacity and type 535 Precast
 Pump manufacturer & model # PE41 Goulds
 Horsepower & GPM 1/2 hp 18 gpm
 Feet of head 18'
 Gallons per cycle 43
 Size of discharge line 2"
 Type & location of alarm Alarm @ Tank
 Water meter Event Counter

DIST. or DROP BOX & TYPE _____


TRENCHES, BEDS, OR GRAVELLESS LEACHFIELD:

Trench/Bed depth _____
 Trench/Bed length _____
 Trench/Bed bottom width _____
 Trench spacing _____
 Drainfield rock below pipe _____
 Size of gravelless pipe _____
 Depth of backfill _____
 Absorption area: square feet _____
 lineal feet _____

MOUNDS:

Percent slope 5%/0
 Upslope sand width 17'
 Downslope sand width 28'
 Sideslope sand width 22'
 Drainfield rock below pipe 9"
 Depth of sand below rock 3'
 Perforation size & spacing 1/4" x 3'
 Pipe size & spacing 1 1/2" x 3'
 Dimensions of rock bed 16 x 25
 Dimensions of sand base 55 x 70
 Final cover 18" T 12" S

DRAWING OF SYSTEM: (include soils)

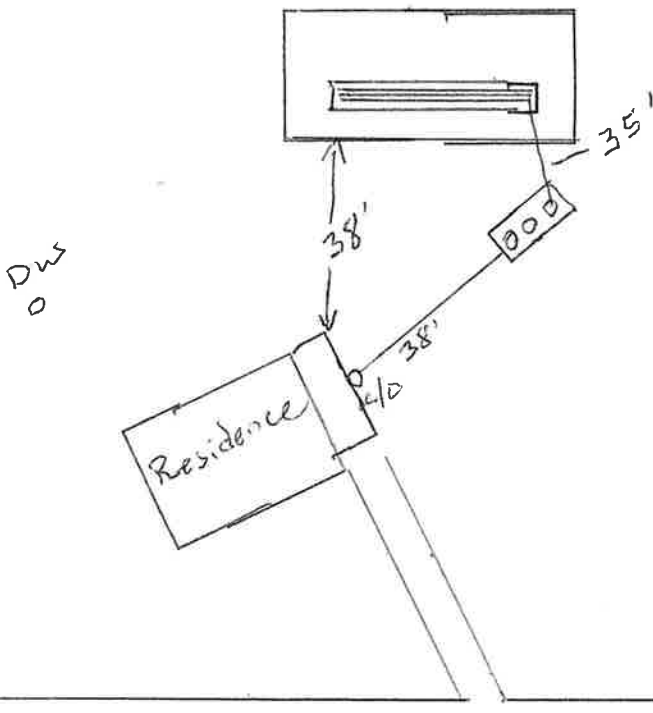

Inspector's Comments: _____

Inspector's Signature K. Linnard Installer's Signature _____