



SALES ORDER

Page: 1

Sales Order Number: SO-164789
Sales Order Date: 12/7/2023

Sold

To: Miscellaneous - Pine River
PO Box 93
1943 27th St SW
Pine River, MN 56474

Ship

To: Julian Johnson Construction
39557 Hwy 18
Aitkin, MN 56474

Tax Ident. Type	Legal Entity	Customer ID	C7900
Ship Via		P.O. Number	TANK
Ship Date	12/7/2023	P.O. Date	12/7/2023
Terms	Due upon receipt of invoice	SalesPerson	

Item No.	Description	Unit	Quantity	Unit Price	Total Price
2250 2CP	6' Max Depth / Capacity: 1568/750	EACH	1	2,834.00	2,834.00
FUEL SURCHARGE	Fuel Surcharge 26	EACH	1	13.46	13.46
HAULAGE CHARGE	Haulage Charge 31	EACH	7	7.00	49.00

check # 7241

Amount Subject to Sales Tax 2896.46
Amount Exempt from Sales Tax 0.00

Subtotal: 2,896.46
Invoice Discount: 0.00
Total Sales Tax: 199.13

Total: 3,095.59

AITKIN COUNTY
CERTIFICATE OF INSTALLATION/~~NOTICE OF NONCOMPLIANCE~~

This certificate of installation/~~notice of noncompliance~~ has been issued this 7th day of December, 2023 to certify compliance/~~noncompliance~~ with Aitkin County's Subsurface Sewage Treatment System Ordinance.

The premises covered by this certificate are legally described as: _____
W 100 FT OF E 593 FT LOT 3, S OF HY 18

Section 30 Township 45 Range 26 Lake Mille Lacs
PERMIT NO. 48386 Owner Name Lora and Richard Wynn
Address 39557 State HWY 18, Aitkin, MN, 56431
Installer Name _____ Self Install _____
Type of System Inspected _____ Type 2 holding tank _____
Parcel Number 36-0-046300

The certificate of installation/~~notice of noncompliance~~ was based on No 1 of the following:

- 1) Inspection of the installation or construction as in accordance with the above referenced permit and application design.

- 2) Review of as-built plans submitted in accordance with Subdivision 9.2 D of Aitkin County's Subsurface Sewage Treatment System Ordinance.

If the above permitted subsurface sewage treatment system is in noncompliance with Aitkin County's Subsurface Sewage Treatment System Ordinance, then the following shall serve as a Notice of Violation:

- 1) Statement of the findings of fact through inspections or investigations: _____

- 2) List of specific violations of Ordinance: _____

- 3) Requirements for correction or removal of violations: _____

- 4) Time schedule for compliance: _____

Failure to correct or remove the above violation(s) will result in this matter being turned over to the Aitkin County Attorney's Office for further legal action, which may result in revocation of licenses or registrations, fines and/or imprisonment.

INSPECTOR SIGNATURE Jody Grund

**SUBSURFACE SEWAGE TREATMENT SYSTEM INSPECTION FORM
AITKIN COUNTY, MINNESOTA**

Township Weatherwood Date of Inspection 12/7/2023 Permit 48386 App. Number 2023-000888
 Owner Lora L Richard A Wynn Parcel Number 36-0-046300
 Project Address 39557 St Hwy 18 Installer Self Install
 City Aitkin Zip Code 56431 Type II holding tank

New Repair

SETBACKS:

Buildings to tank(s) 15'
 Buildings to drainfield N/A
 Well(s) 50' or 100' > 100'
 Lake/Creek/Wetland > 75'

SEPTIC TANKS: New Existing

Number of tanks installed 1
 Liquid capacity and type 2250 Brown Wilbert
 Type of baffle Plastic
 Inspection pipes _____
 Manholes size 3x24
 Manhole to grade Yes No

PUMPS: New Existing

Tank capacity and type _____
 Pump manufacturer & model # _____
 Horsepower & GPM _____
 Feet of head _____
 Gallons per cycle _____
 Size of discharge line _____
 Type & location of alarm _____
 Water meter _____

DIST. or DROP BOX & TYPE _____


TRENCHES, BEDS, OR GRAVELLESS LEACHFIELD:

Trench/Bed depth _____
 Trench/Bed length _____
 Trench/Bed bottom width _____
 Trench spacing _____
 Drainfield rock below pipe _____
 Size of gravelless pipe _____
 Depth of backfill _____
 Absorption area: square feet _____
 lineal feet _____

MOUNDS:

Percent slope _____
 Upslope sand width _____
 Downslope sand width _____
 Sideslope sand width _____
 Drainfield rock below pipe _____
 Depth of sand below rock _____
 Perforation size & spacing _____
 Pipe size & spacing _____
 Dimensions of rock bed _____
 Dimensions of sand base _____
 Final cover _____

DRAWING OF SYSTEM: (include soils)

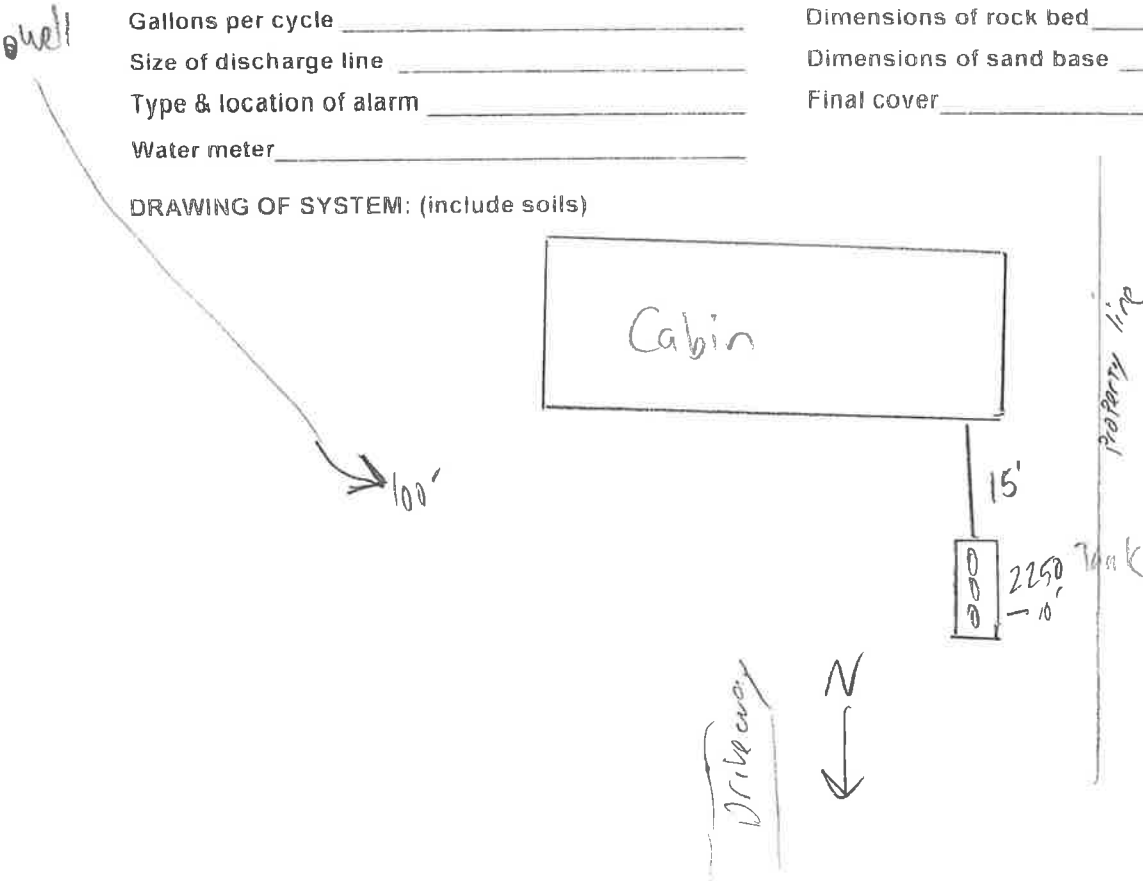

Inspector's Comments: _____

Inspector's Signature [Signature] Installer's Signature _____