



C.
L

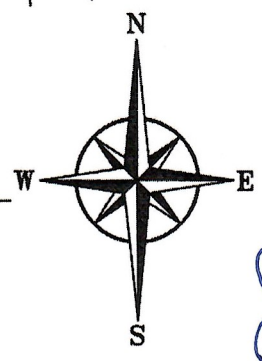

(W) - well
(S) - septic

SCALE
1" = 30'

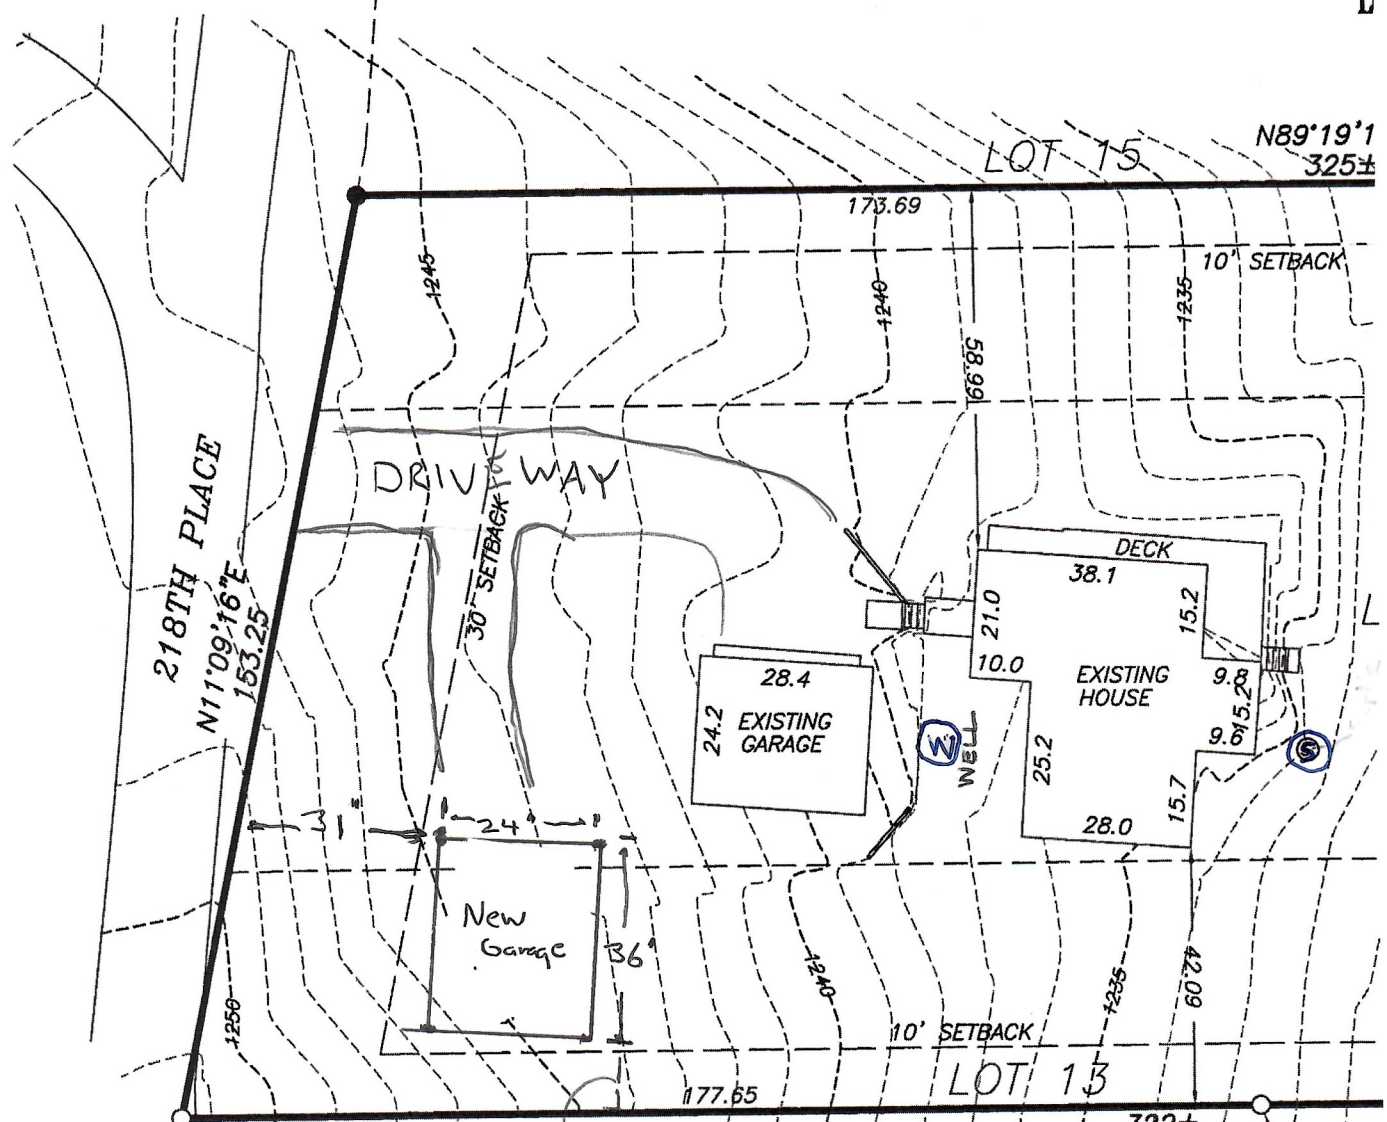

BEARINGS ARE BASED ON NAD83(2011)
AITKIN COUNTY COORDINATE SYSTEM

NORTHWESTERN
SURVEYING & ENGINEERING, INC.
P.O. Box 3067 - Bemidji Minnesota - 56619