

↑ North



Woods

Woods

Woods



wood shed

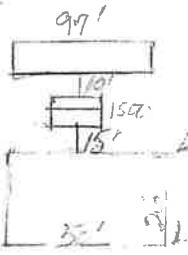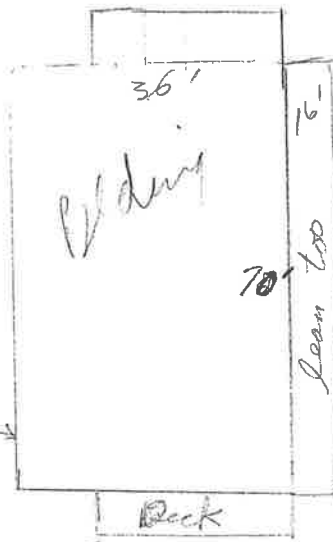

app# 2003-001083

2003-001083
 2003-001083
 Water supply
 #11201 Round
 Sptic system

machine shed

Woods
 deep well

1/2
 to
 road

Woods

(4) Acres

DALE VOLTIN

to Rd

pid# 21-0-058200

28796 720th st.

Highway 20