


29-1-540960

Holding Tank Design

Property Owner: Jason Kadd Bach

Date: 10-2-23

Please Draw to Scale with North Arrow to top or Left Side of Page

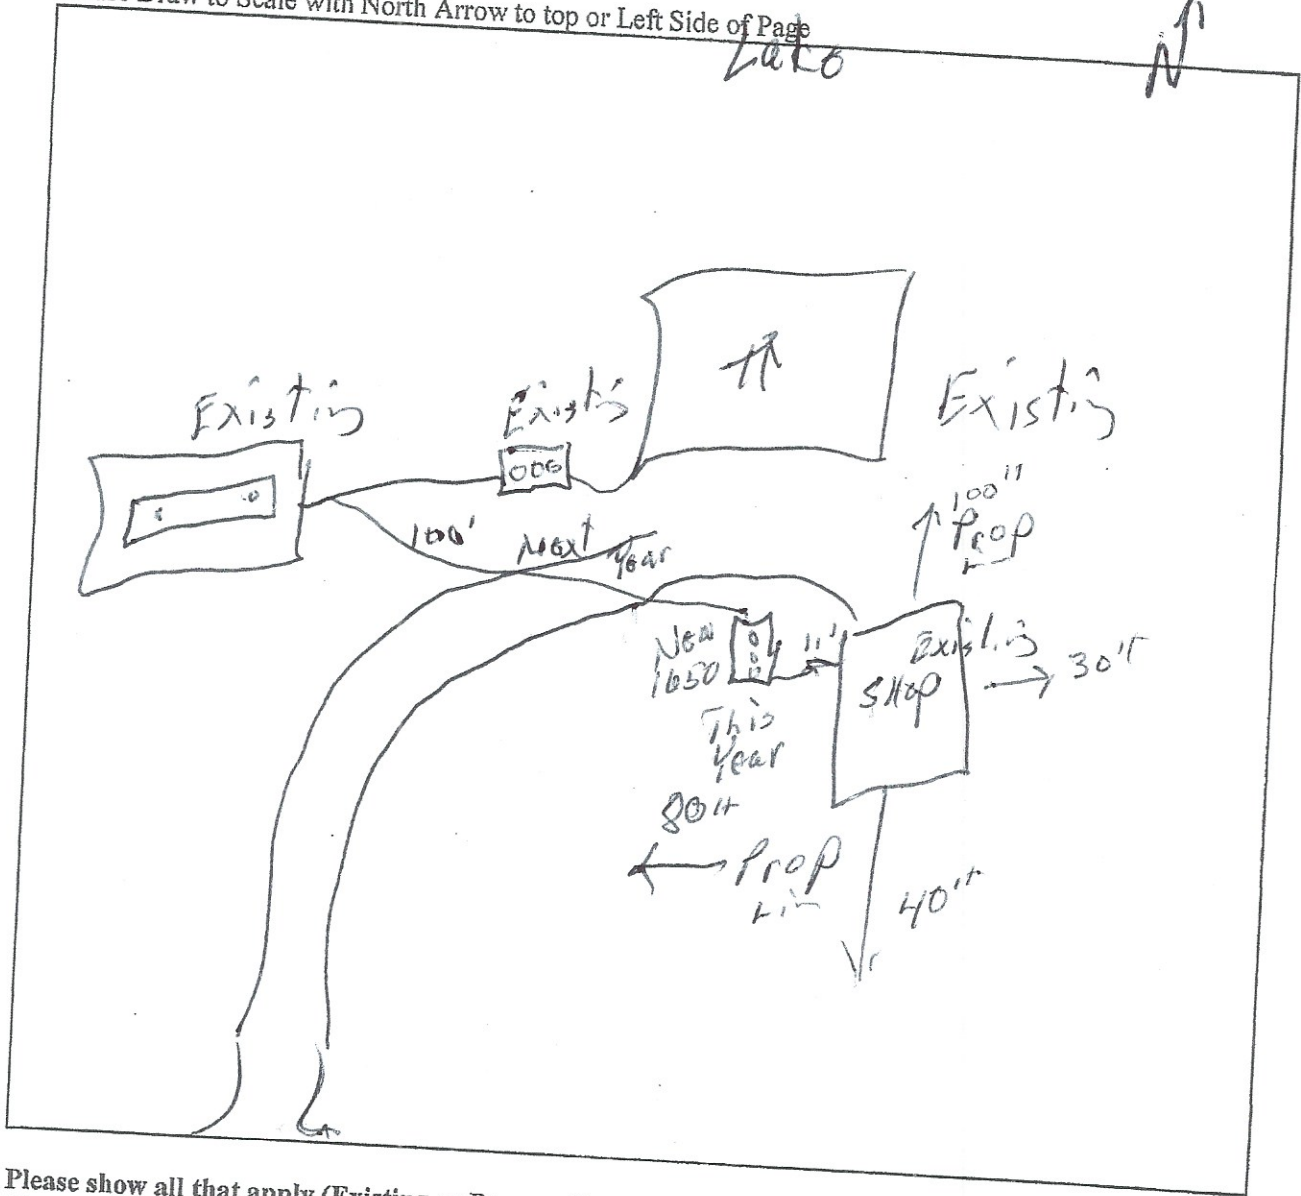

Please show all that apply (Existing or Proposed):

- Wells within 100 ft. of a Drainfield
- Water lines within 10 ft. of a Drainfield
- Disturbed/Compacted Areas
- Drainfield Areas

- Boring Locations
- Component Location
- OHW
- Lot Easements

- Access Route for Tank Maintenance
- Property Lines
- Structures
- Setbacks

Elevations:

- 100" Benchmark Elevation
- 90" Elevation of Sewer Line at House
- 78" Tank Inlet Elevation
- Existing Drainfield Elevation

- 27" Pump Elevation
- _____ Pump Discharge Elevation
- _____ Restricting Layer Elevation

*installed
to be solved
Next Year
2024*

Designer Signature: Bob Bault
License Number: 2088

Date: 10-2-23
Page _____ of _____