


David & Carleen McMillan
PID: 08-0-022700

Approved for
-6240 sf New Residence
includes porches, garages, etc
(78 x 80 wood frame building
envelope)
-4 Bdrm Type 1 Mound Septic

Jun 17, 2024 at 12:42:51 PM
43837-43853 Nature Ave
Palisade MN 56469
United States



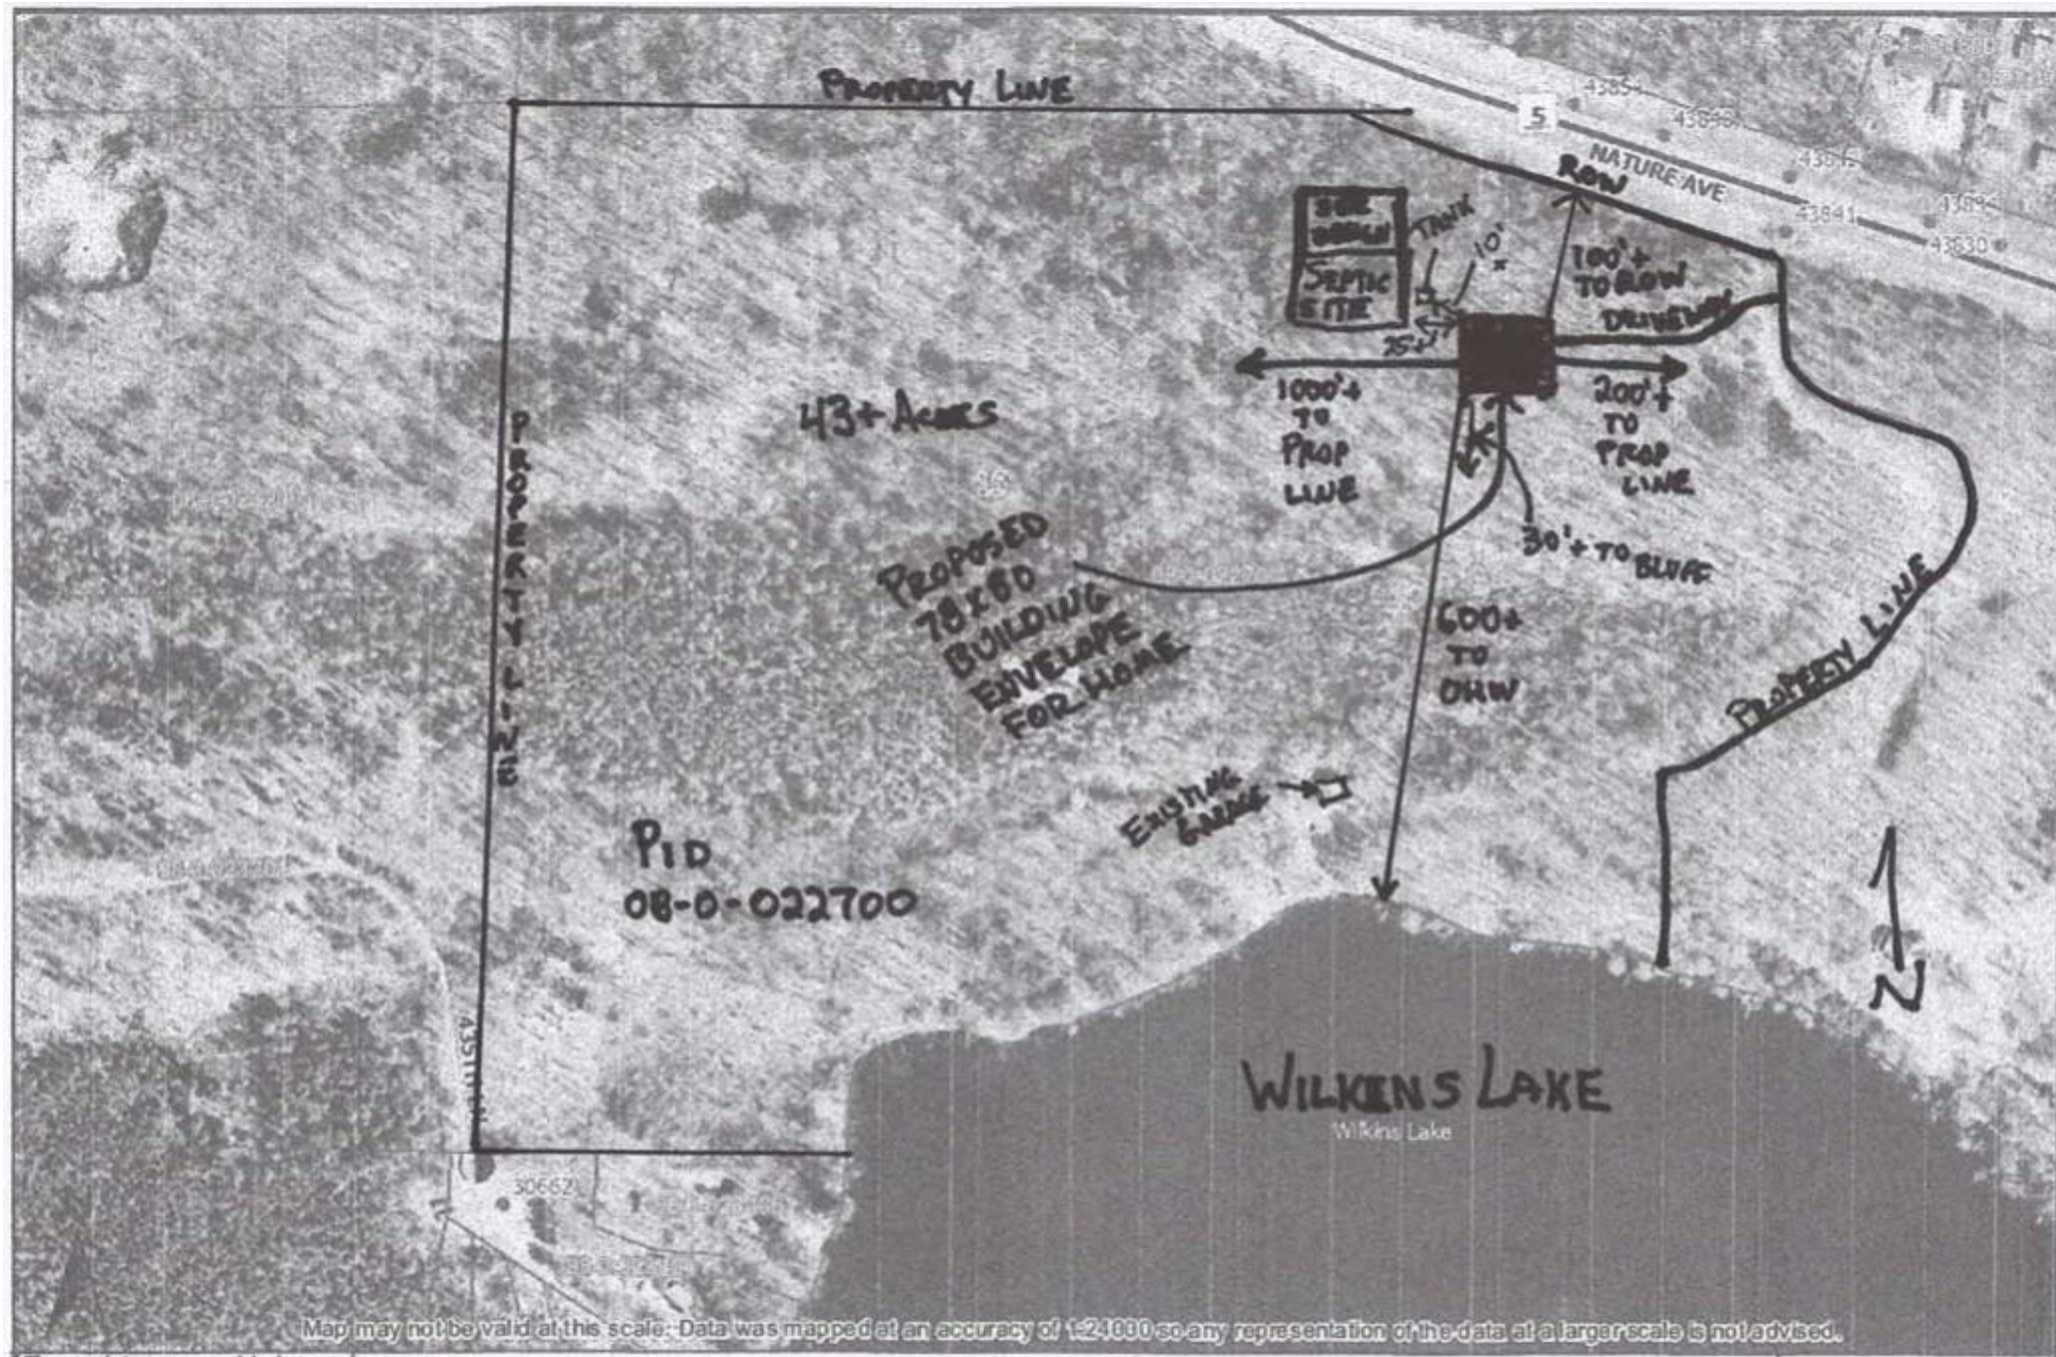

4 Bdrm Type 1 Mound Septic

Jun 17, 2024 at 12:44:26 PM
43855-43899 Nature Ave
Palisade MN 56469
United States

