

**AITKIN COUNTY**  
**CERTIFICATE OF INSTALLATION/~~NOTICE OF NONCOMPLIANCE~~**

This certificate of installation/~~notice of noncompliance~~ has been issued this 4th day of October, 2024 to certify compliance/~~noncompliance~~ with Aitkin County's Subsurface Sewage Treatment System Ordinance.

The premises covered by this certificate are legally described as: \_\_\_\_\_  
(NW NW) LOT 4 LYING SW OF ST HWY 65 LESS THE  
E 100 FT

Section 5 Township 46 Range 23 Lake \_\_\_\_\_  
PERMIT NO. 48947 Owner Name Charles Gile  
Address 33959 State Hwy 65 McGregor, Mn 55760  
Installer Name Ritter Sewer & Excavating  
Type of System Inspected 2 Bdrm Type III Mound  
Parcel Number 26-0-007200

The certificate of installation/~~notice of noncompliance~~ was based on No 1 of the following:

- 1) Inspection of the installation or construction as in accordance with the above referenced permit and application design.
  
- 2) Review of as-built plans submitted in accordance with Subdivision 9.2 D of Aitkin County's Subsurface Sewage Treatment System Ordinance.

If the above permitted subsurface sewage treatment system is in noncompliance with Aitkin County's Subsurface Sewage Treatment System Ordinance, then the following shall serve as a Notice of Violation:

- 1) Statement of the findings of fact through inspections or investigations:

\_\_\_\_\_

- 2) List of specific violations of Ordinance: \_\_\_\_\_

\_\_\_\_\_

- 3) Requirements for correction or removal of violations: \_\_\_\_\_

\_\_\_\_\_

- 4) Time schedule for compliance: \_\_\_\_\_

Failure to correct or remove the above violation(s) will result in this matter being turned over to the Aitkin County Attorney's Office for further legal action, which may result in revocation of licenses, fines and/or imprisonment.

INSPECTOR SIGNATURE 

SUBSURFACE SEWAGE TREATMENT SYSTEM INSPECTION FORM

AITKIN COUNTY, MINNESOTA

2024-001659

Township Rice River Date of Inspection 10-1-24 Initial 10-4-24 Final App. Number 48947

Owner Charles Gile Parcel Number 26-0-007200

Project Address 33959 St Hwy 65 Installer Ritter Exc

City McGregor Zip Code 55760

New  Repair

SETBACKS:

Buildings to tank(s) 23'

Buildings to drainfield >100'

Well(s) 50' or 100' Existing >50'

Lake/Creek/Wetland ---

SEPTIC TANKS: New  Existing

Number of tanks installed 1650 Combo

Liquid capacity and type Jacobson - Insulated

Type of baffle Plastic Waterproofed

Inspection pipes ---

Manholes size 1 @ 20" 2 @ 24"

Manhole to grade Yes  No

PUMPS: New  Existing

Tank capacity and type 530 per tank

Pump manufacturer & model # Grundfos PE51

Horsepower & GPM .5 hp 15 gpm

Feet of head 22'

Gallons per cycle 45

Size of discharge line 2"

Type & location of alarm elec @ Tank

Water meter front counter

DIST. or DROP BOX & TYPE ---

TRENCHES, BEDS, OR GRAVELLESS LEACHFIELD:

Trench/Bed depth ---

Trench/Bed length ---

Trench/Bed bottom width ---

Trench spacing ---

Drainfield rock below pipe ---

Size of gravelless pipe ---

Depth of backfill ---

Absorption area: square feet ---

lineal feet ---

MOUNDS: 2 Bed Type III Mound

Percent slope 0

Upslope sand width 20'

Downslope sand width 20'

Sideslope sand width 20'

Drainfield rock below pipe 9"

Depth of sand below rock 36"

Perforation size & spacing 1/4" x 3"


Pipe size & spacing 1 1/2" x 3"

Dimensions of rock bed 12 x 25

Dimensions of sand base 50' x 105'

Final cover 18" T 12" S

DRAWING OF SYSTEM: (include soils)

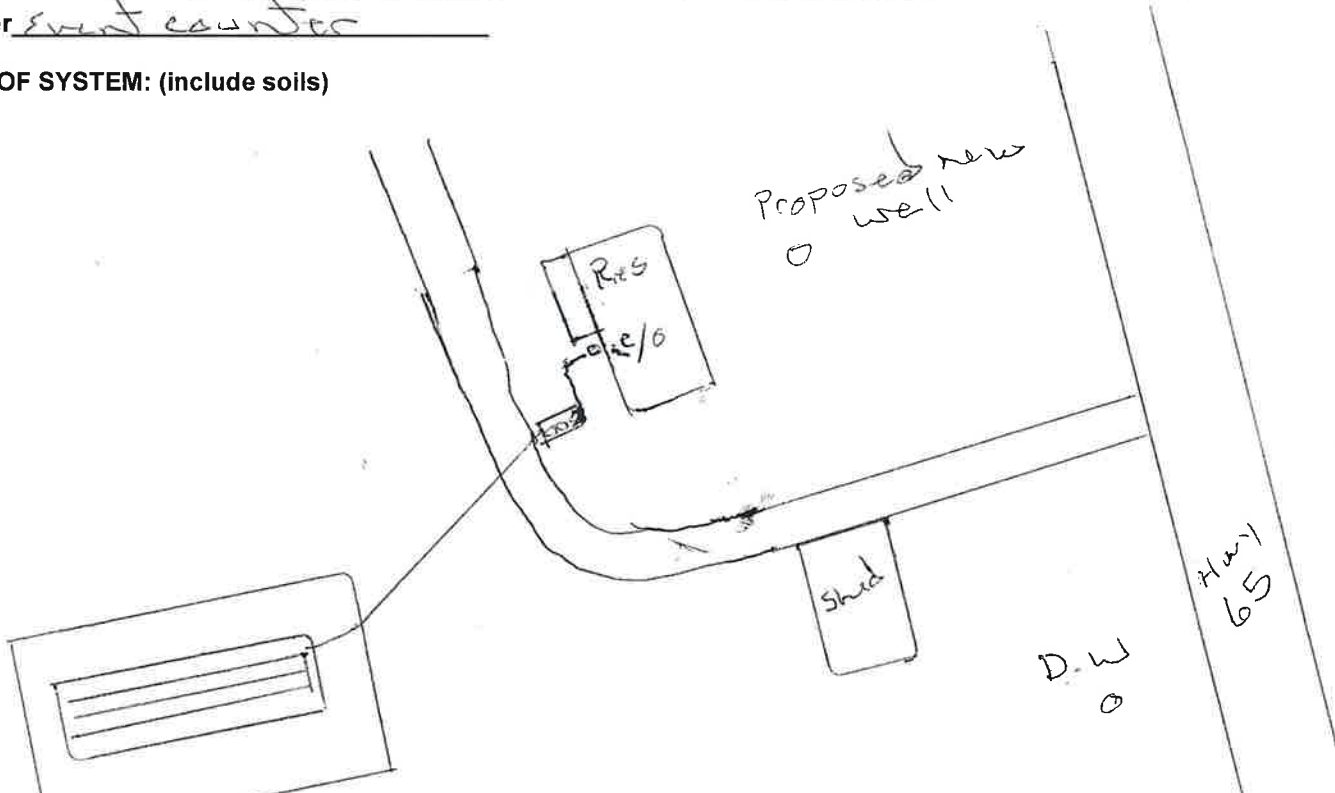

Inspector's Comments: ---

Inspector's Signature [Signature] Installer's Signature ---