
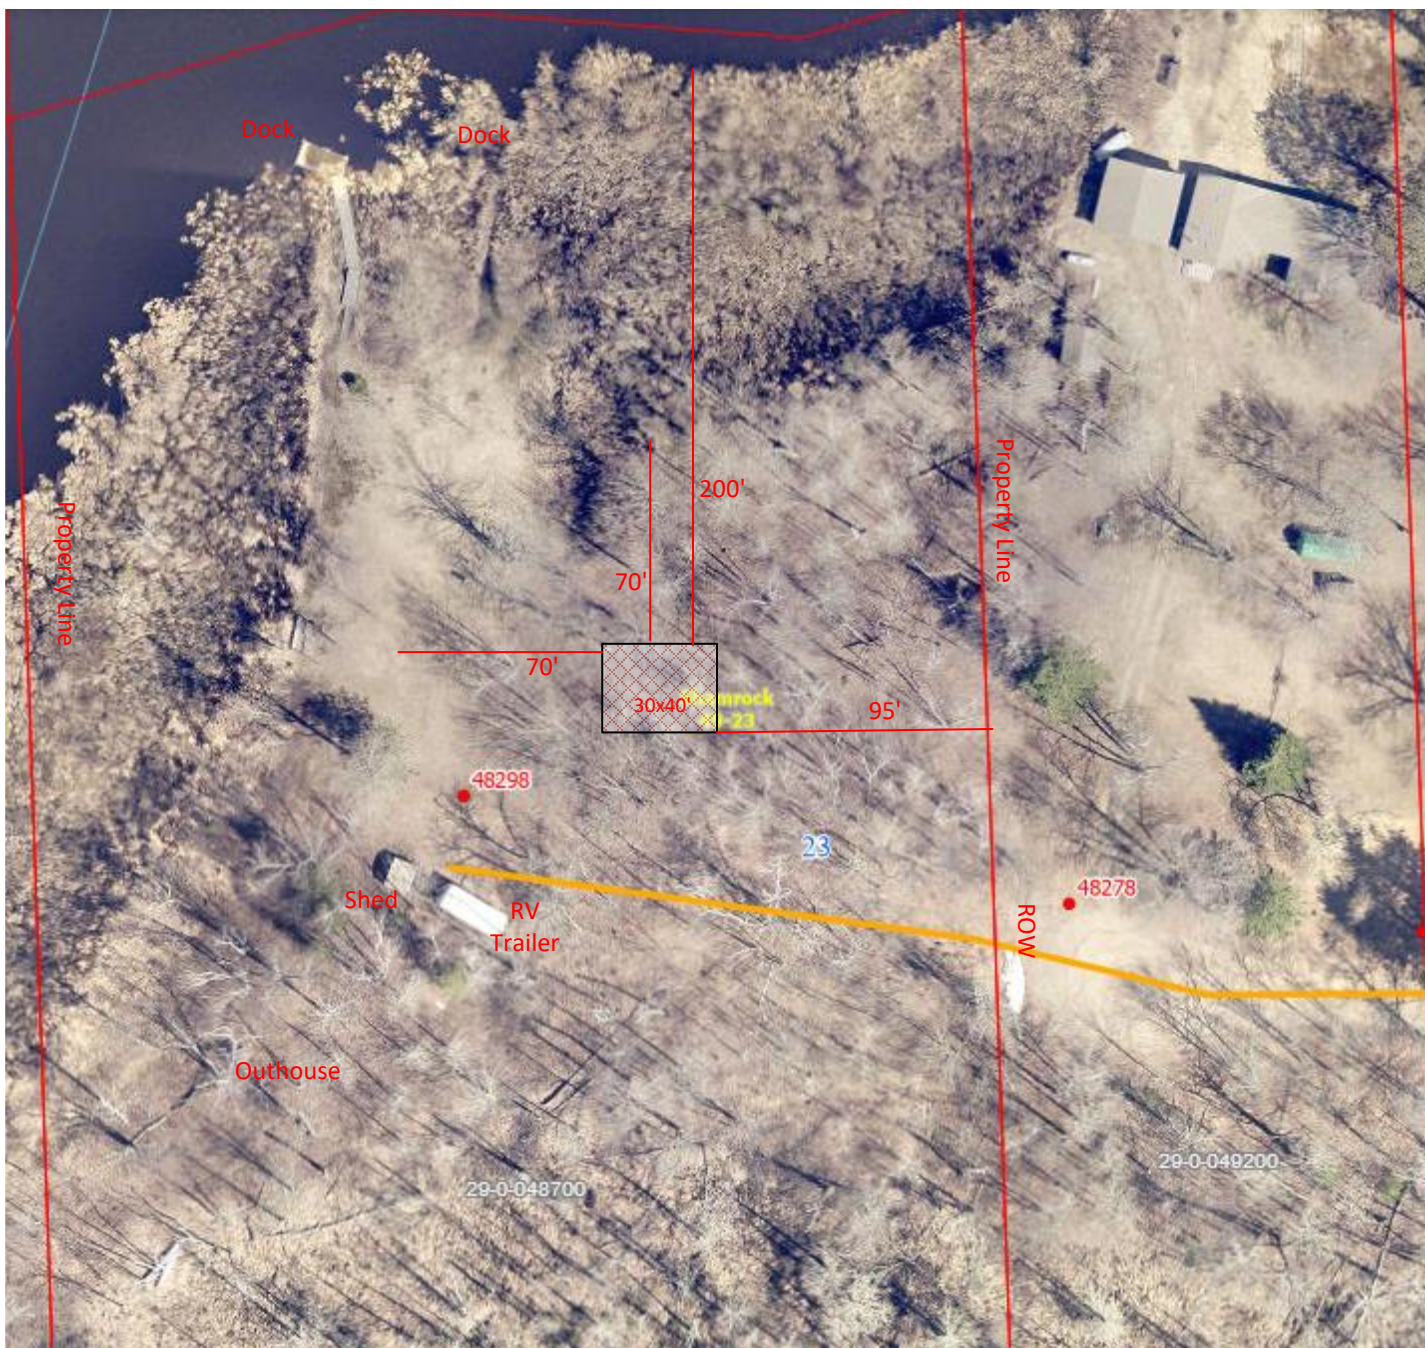


Wimler Pole Barn Application - 48298 170th Pl

Scale: Feet

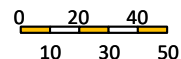

Parcels: 29-0-048700  
 Property ID (PIN): 29-0-048700  
 Tax District: SHAMROCK TWP  
 Owner Name: WIMLER, JENNIFER A & FRANK C III  
 Owner Address: 810 NW 66TH AVE  
 Owner Address 2: DES MOINES IA 50313  
 Township: 49.0  
 Range: 23  
 Section: 23  
 Physical House Number: 48298  
 Physical Address: 48298 170th Pl  
 Physical City: MCGREGOR  
 Physical Zip: 55760

Lake ID: 1003400  
 Lake Name: HORSESHOE LAKE (SHAMROCK)  
 Brief Legal: ALL LOT 7 LESS E 1160 FT & 145 x 1420 FT IN LOT 7 1015 FT W OF SE CORNER  
 Estimated Acres: 9.5  
 Class Code: 151  
 Classification: Non-Comm Seasonal Residential Recreational  
 Class Code 2: 111  
 Classification 2: Rural Vacant Land



