


CERTIFICATE OF SURVEY

OF PART OF GOV'T LOT 2,
SEC. 9, TWP. 46, RGE. 25,
AITKIN COUNTY, MINNESOTA

EAST LINE OF GOV'T LOT 3 AND
WEST LINE OF GOV'T LOT 2

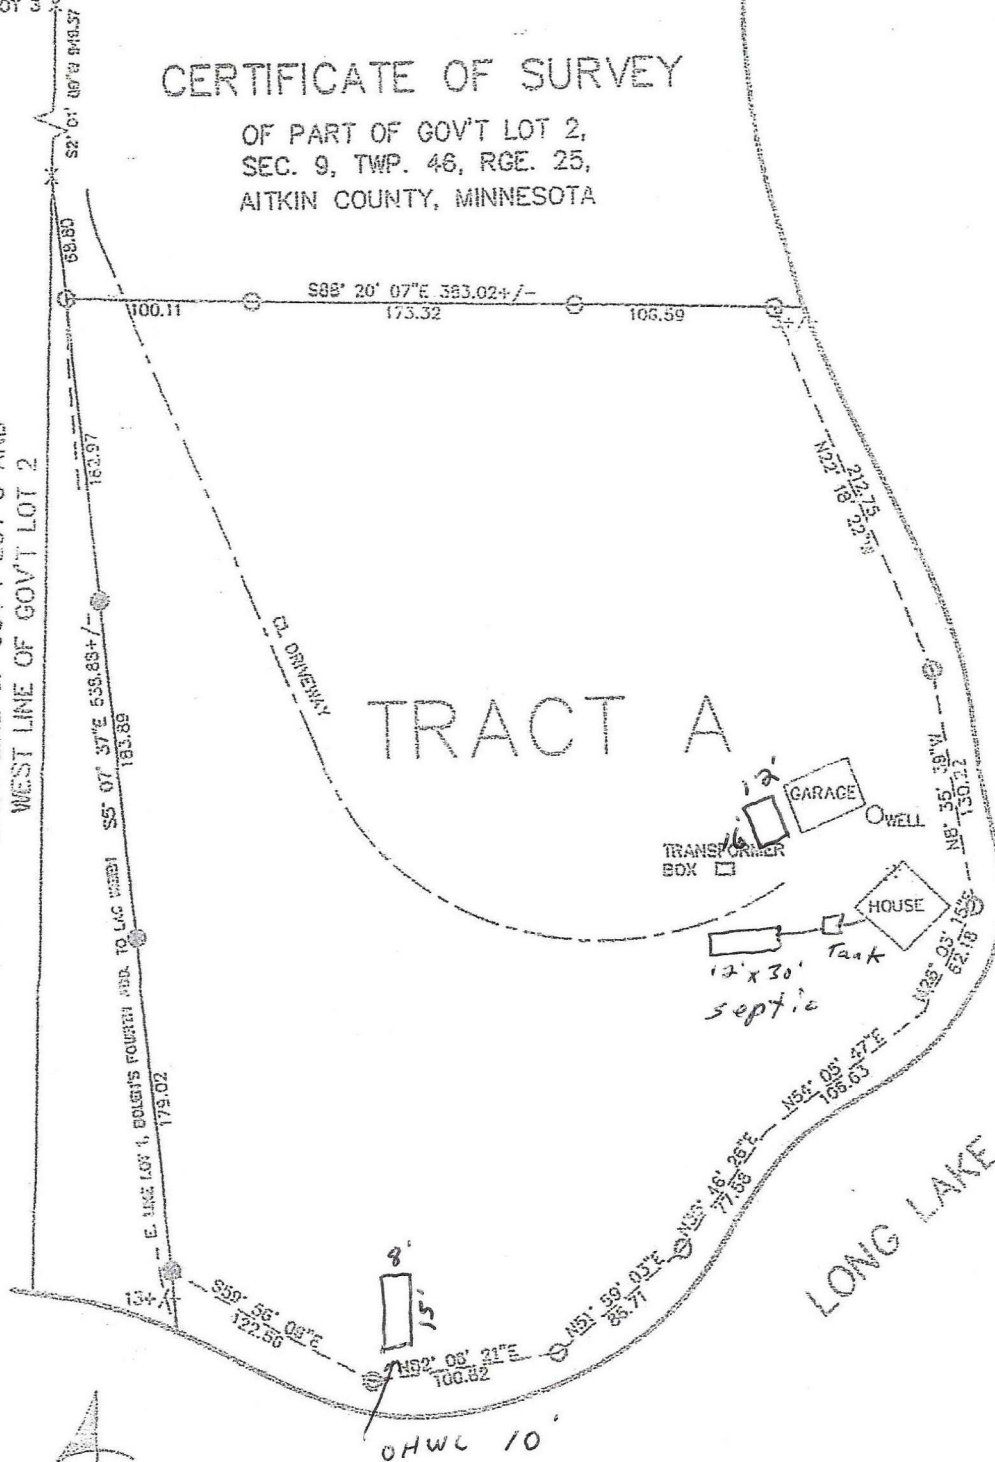

SCALE: 1 INCH = 100 FEET



- FOUND IRON
 - SET 3/8" RE-BAR RLS 17774
- BEARING DATUM BASED ON AITKIN COUNTY COORDINATE SYSTEM

MARVIN KOHOUT
 LICENSED LAND SURVEYOR
 PO BOX 384
 AITKIN, MN 56431-0384
 218-927-5452

I HEREBY CERTIFY THAT THIS SURVEY PLAN OR REPORT WAS PREPARED BY ME OR UNDER MY DIRECT SUPERVISION AND THAT I AM A DULY LICENSED LAND SURVEYOR UNDER THE LAWS OF THE STATE OF MINNESOTA.

Marvin R. Kohout
 DATE 17 July 2015 LIC. NO. 17774