

AITKIN COUNTY
CERTIFICATE OF INSTALLATION/~~NOTICE OF NONCOMPLIANCE~~

This certificate of installation/~~notice of noncompliance~~ has been issued this 14th day of September, 2017 to certify compliance/~~noncompliance~~ with Aitkin County's Subsurface Sewage Treatment System Ordinance.

The premises covered by this certificate are legally described as: Lot 165
Sheshebe Point

Section 21 Township 49 Range 23 Lake Minnewawa
PERMIT NO. 41885 Owner Name Bret & Toni Anderson
Address 19356 486th St, McGregor, MN
Installer Name Keller Excavating
Type of System Inspected Type II holding tanks
Parcel Number 29-1-159550

The certificate of installation/~~notice of noncompliance~~ was based on No 2 of the following:

- 1) Inspection of the installation or construction as in accordance with the above referenced permit and application design.

- 2) Review of as-built plans submitted in accordance with Subdivision 9.2 D of Aitkin County's Subsurface Sewage Treatment System Ordinance.

If the above permitted subsurface sewage treatment system is in noncompliance with Aitkin County's Subsurface Sewage Treatment System Ordinance, then the following shall serve as a Notice of Violation:

- 1) Statement of the findings of fact through inspections or investigations:

- 2) List of specific violations of Ordinance: _____

- 3) Requirements for correction or removal of violations: _____

- 4) Time schedule for compliance: _____

Failure to correct or remove the above violation(s) will result in this matter being turned over to the Aitkin County Attorney's Office for further legal action, which may result in revocation of licenses, fines and/or imprisonment.

INSPECTOR SIGNATURE *Kenn Durick*

AITKIN COUNTY AS-BUILT FORM FOR AN ISTS

OWNER Bret Anderson
 INSTALLER Kurt Kelley

PERMIT NUMBER 41885
 DATE OF INSTALLATION 9-14-17

SETBACKS:

Buildings to tank(s) 14'
 Building to drainfield _____
 Well(s) 50' or 100' 90'
 Lake/Creek/Wetland 150'
 Property lines (drainfield/tanks) 12'

SEPTIC TANKS:

Liquid Capacity 2-1500 - holding Tank
 Manufacturer & Type Jacobson
 Type of baffle(s) Plastic
 Inspection pipes (#, size & height) 6" 2'
 Manhole access (size) 24"
 # and height of risers on manhole 1ft

MOUNDS:

Percent slope _____
 Upslope dike width _____
 Downslope dike width _____
 Sideslope dike width _____
 Drainfield rock below pipe _____
 Depth of sand below rock _____
 Perforation size & spacing _____
 Pipe size & spacing _____
 Dimensions of rockbed _____
 Dimensions of sandbase _____
 Depth of final cover _____

TRENCHES, BEDS OR AT-GRADE SYSTEMS:


Drop box or Dist. Box and Type _____
 Trench depth(s) _____
 Trench length(s) _____
 Trench bottom width _____
 trench spacing _____
 Drainfield rock below pipe _____
 Size of graveless pipe _____
 Depth of backfill _____
 Absorption area: square feet _____
 lineal feet _____

NUMBER OF PICTURES TAKEN: _____

PUMPS:

Tank capacity _____
 Tank manufacturer & type _____
 # and height of risers _____
 Pump manufacturer and model # _____
 Horsepower and GPM _____
 Feet of head _____
 Cycles/day & Gallons/cycle _____
 Size of discharge line _____
 Type of electrical hookup _____
 Type and location of alarm _____
 Cycle counter type & location _____

DRAWING OF SYSTEM – use back of this sheet if more room is needed.

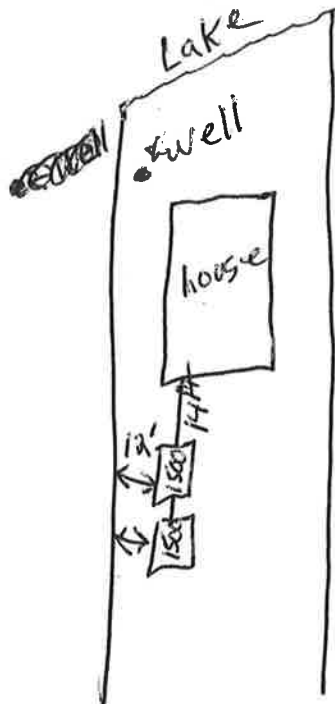

I Kurt Kelley (installer signature) certify that the above work was installed in accordance with the submitted design and permit conditions and the system is free from defects.