


← N

Round Lake

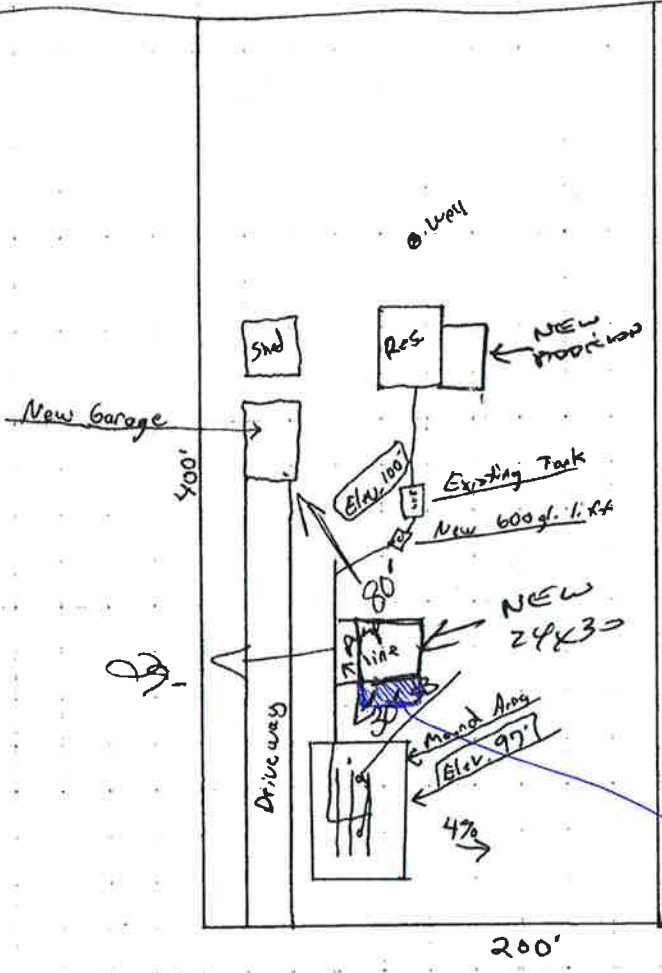

□ = 20'

Dave Tropp
26060 141st
Zimmerman Mn. 55398

Mark Fisher
MPCA # 698
927-4125

No Wells within 100'
of tanks or mound.

Veg. type Small trees
& brush

32x12