

FIELD EVALUATION SHEET

NAME Scott Nelson PERMIT # 2006-000
PARCEL # 35-0-025406 TWP 49-26 SECTION 16

CHECK THE FOLLOWING PRIOR TO INSPECTION

B. Hargrave NAME OF SITE EVALUATOR
NAME OF DESIGNER
NAME OF INSTALLER

- LOT OF RECORD BEFORE 1-21-92 (SL) IR 1-10-95 (NSL), IF NO, ALT. SITE? _____
- _____ SITE PLAN WITH SETBACK DISTANCES AND DIMENSIONS
- _____ ARE ISTS SITES PROTECTED FROM DAMAGE? IF NOT, WHEN _____
- _____ DESIGN _____ PERC TESTS _____ SOIL BORINGS, 2 PER SITE
- _____ NUMBER OF BEDROOMS (INCLUDE POTENTIAL)
- _____ CROSS SECTION SHEET _____ TRENCH DESIGN SHEET
- _____ MOUND DESIGN SHEET _____ OTHER OR PERFORM.
- _____ PRESSURE DISTRIBUTION SHEET _____ PUMP CALC. TEST
- _____ WATER USE CALCULATIONS _____
- _____ GARBAGE DISPOSAL _____ HOT TUB
- _____ EASEMENTS ON LOT, IS ROAD PUBLIC OR PRIVATE SEE DEED/PLAT
- _____ NATURAL LANDSCAPE PROTECTION PLAN

STAKING: BUILDINGS , DRAINFIELD , BORINGS _____, WELL _____
BUILDING SETBACKS: ROAD _____, SIDE _____, REAR _____, BLUFF _____,
LAKE/RIVER _____

COMPLETE DURING SITE EVALUATION

BUILDINGS STAKED DRAINFIELD STAKED _____ BORINGS STAKED
_____ WELL STAKED

SETBACKS (MEASURE DISTANCE)

	<u>DRAINFIELD</u>	<u>HOUSE</u>	
	YES/NO	YES/NO	
FLOOD PLAIN	_____	_____	see site plan ✓
WETLANDS	_____	_____	
LAKE, RIVER, PROTECTED WATERS	_____	_____	
ROAD RIGHT OF WAY	_____	_____	
BLUFF	_____	_____	
SIDE LOT LINE	_____	_____	
REAR LOT LINE	_____	_____	
HOUSE OR OTHER STRUCTURE	_____	_____	
WELL	_____	_____	
EASEMENTS	_____	_____	
NEIGHBORING WELL (S) TO ISTS	_____ (1) _____ (2) _____ (3) _____ (4)		
DRAINFIELD AREA DISTURBED	_____		

CONFORMING SEPTIC SYSTEM: No YES _____ NO If no, list reasons below.
COMMENTS OR PROBLEMS (drainage, swales, wetlands, need gutters, etc.) _____

APPROVED: YES OR NO


INSPECTORS NAME Bryan Hargrave DATE 5/13/2016 # PICTURES 12

SOIL BORING LOGS AND SKETCH PLAN ON REVERSE SIDE

CLIENT: Scott Nelson

DATE: 4-23-16

MAP DRAWN TO SCALE WITH A NORTH ARROW

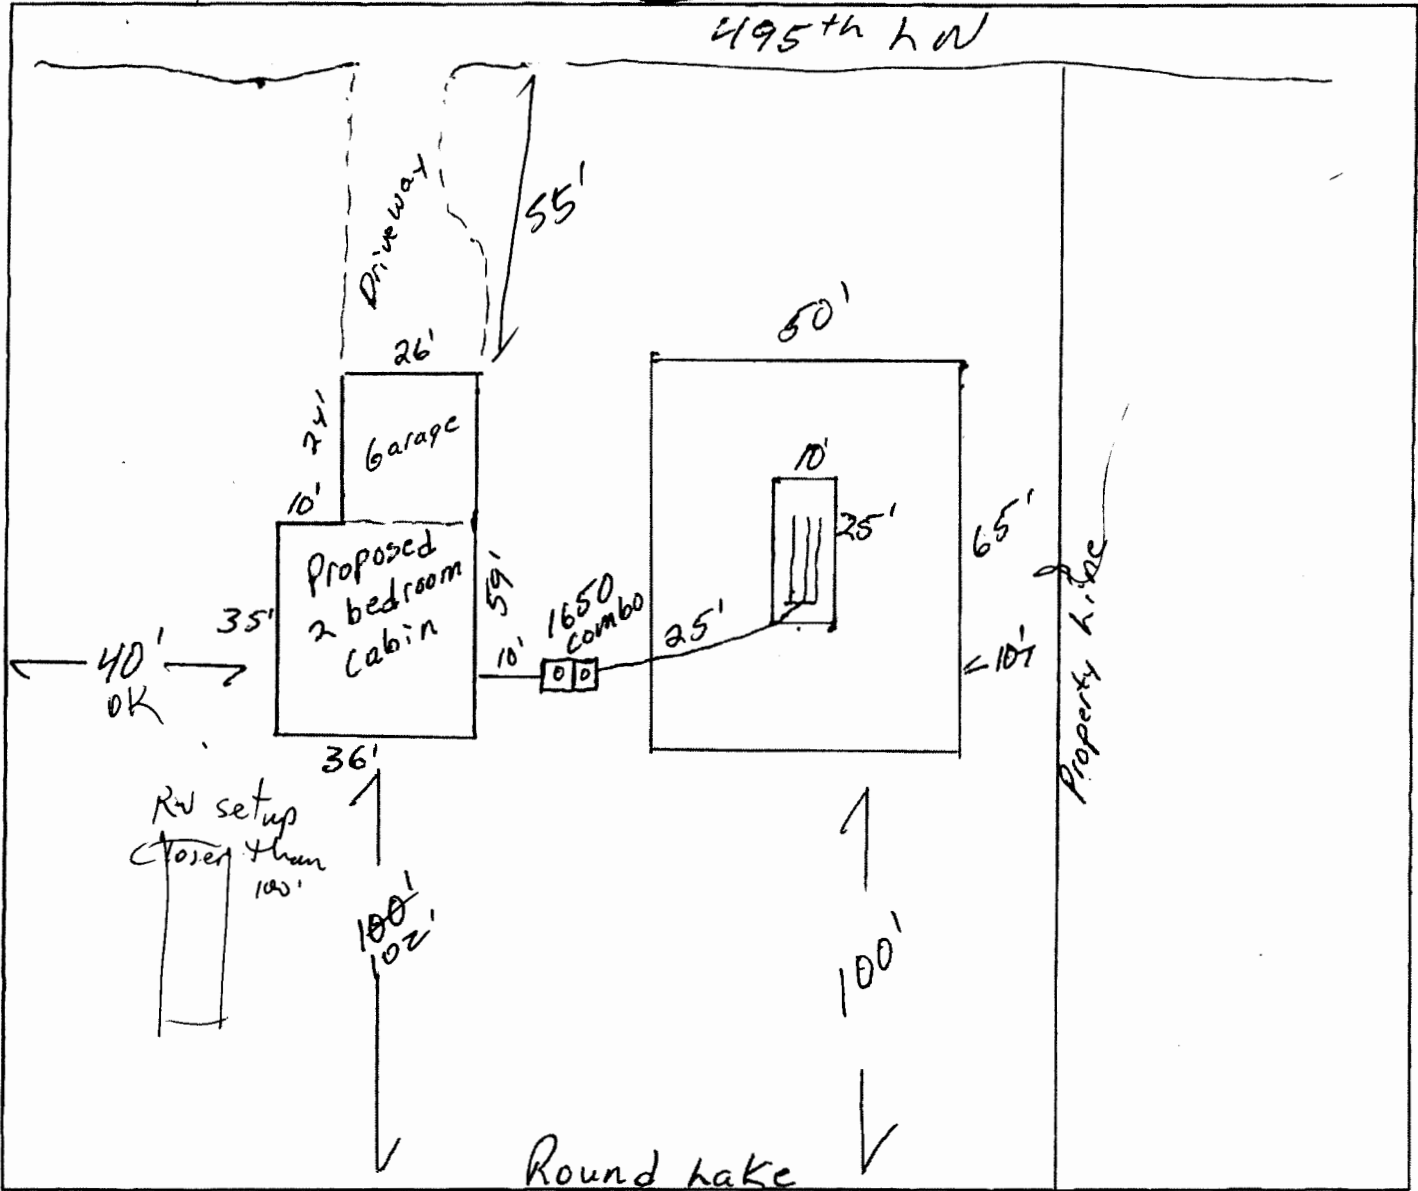

CHECK OFF LIST-HAVE ALL OF THE FOLLOWING BEEN DRAWN ON THE MAP??

SHOW EXISTING OR PROPOSED

- WATER WELLS WITHIN 100 FT OF TREATMENT AREAS
- PRESSURE WATER LINES WITHIN 10 FT OF TREATMENT AREAS
- STRUCTURES
- ALL SOIL TREATMENT AREAS
- HORIZONTAL AND VERTICAL REFERENCE
- POINT OF SOIL BORINGS
- LOT EASEMENTS
- DISTURBED/ COMPACTED AREAS
- SITE PROTECTION-LATHE AND RIBBON EVERY 15 FT
- ACCESS ROUTE FOR TANK MAINTENANCE
- LOT IMPROVEMENTS
- ALL ISTS COMPONENTS
- DIRECTION OF SLOPE
- ALL LOT DIMENSIONS

REQUIRED SETBACKS

- STRUCTURES
- OHWL
- PROPERTY LINES

COMMENTS:

INDICATE ELEVATIONS

BENCHMARK

- ELEVATION OF SEWER LINE @ HOUSE 100.5
- ELEVATION @ TANK INLET 100.5
- ELEVATION @ BOTTOM OF ROCK LAYER 97.5
- ELEVATION @ BOTTOM OF BORING OR RESTRICTIVE LAYER 100.5
- ELEVATION OF PUMP 104.5
- ELEVATION OF DISTRIBUTION DEVICE 96.15

DESIGNER SIGNATURE RodK
LICENSE# 211

DATE 4-23-16