

**FIELD EVALUATION SHEET**

NAME David Sonnes PERMIT # 2016-000156  
 PARCEL # 19-0-046901 TWP 49-25 SECTION 27

**CHECK THE FOLLOWING PRIOR TO INSPECTION**

B. Hargrave NAME OF SITE EVALUATOR  
 \_\_\_\_\_ NAME OF DESIGNER  
 \_\_\_\_\_ NAME OF INSTALLER

- LOT OF RECORD BEFORE 1-21-92 (SL) IR 1-10-95 (NSL), IF NO, ALT. SITE?
- \_\_\_\_\_ SITE PLAN WITH SETBACK DISTANCES AND DIMENSIONS
- \_\_\_\_\_ ARE ISTS SITES PROTECTED FROM DAMAGE? IF NOT, WHEN \_\_\_\_\_
- \_\_\_\_\_ DESIGN \_\_\_\_\_ PERC TESTS \_\_\_\_\_ SOIL BORINGS, 2 PER SITE
- \_\_\_\_\_ NUMBER OF BEDROOMS (INCLUDE POTENTIAL)
- \_\_\_\_\_ CROSS SECTION SHEET \_\_\_\_\_ TRENCH DESIGN SHEET
- \_\_\_\_\_ MOUND DESIGN SHEET \_\_\_\_\_ OTHER OR PERFORM.
- \_\_\_\_\_ PRESSURE DISTRIBUTION SHEET \_\_\_\_\_ PUMP CALC. TEST
- \_\_\_\_\_ WATER USE CALCULATIONS \_\_\_\_\_
- \_\_\_\_\_ GARBAGE DISPOSAL \_\_\_\_\_ HOT TUB
- \_\_\_\_\_ EASEMENTS ON LOT, IS ROAD PUBLIC OR PRIVATE SEE DEED/PLAT
- \_\_\_\_\_ NATURAL LANDSCAPE PROTECTION PLAN

STAKING: BUILDINGS , DRAINFIELD \_\_\_\_\_, BORINGS \_\_\_\_\_, WELL \_\_\_\_\_  
 BUILDING SETBACKS: ROAD \_\_\_\_\_, SIDE \_\_\_\_\_, REAR \_\_\_\_\_, BLUFF \_\_\_\_\_,  
 LAKE/RIVER \_\_\_\_\_

**COMPLETE DURING SITE EVALUATION**

BUILDINGS STAKED  DRAINFIELD STAKED \_\_\_\_\_ BORINGS STAKED  
 \_\_\_\_\_ WELL STAKED

**SETBACKS (MEASURE DISTANCE)**

	<u>DRAINFIELD</u>	<u>HOUSE</u>	
	YES/NO	YES/NO	
	YES/NO	YES/NO	
FLOOD PLAIN	_____	_____	see site plan ↓
WETLANDS	_____	_____	
LAKE, RIVER, PROTECTED WATERS	_____	_____	
ROAD RIGHT OF WAY	_____	_____	
BLUFF	_____	_____	
SIDE LOT LINE	_____	_____	
REAR LOT LINE	_____	_____	
HOUSE OR OTHER STRUCTURE	_____	_____	
WELL	_____	_____	
EASEMENTS	_____	_____	
NEIGHBORING WELL (S) TO ISTS	_____ (1) _____ (2)	_____ (3) _____ (4)	
DRAINFIELD AREA DISTURBED	_____	_____	

CONFORMING SEPTIC SYSTEM: Now YES \_\_\_\_\_ NO If no, list reasons below.  
 COMMENTS OR PROBLEMS (drainage, swales, wetlands, need gutters, etc.) \_\_\_\_\_

APPROVED: YES OR NO

INSPECTORS NAME Bryan Hargrave DATE 5/13/2016 # PICTURES \_\_\_\_\_


SOIL BORING LOGS AND SKETCH PLAN ON REVERSE SIDE

SOIL BORING LOG #1			SOIL BORING LOG #2		
DEPTH	TEXTURE	COLOR	DEPTH	TEXTURE	COLOR
0-13"	SL	10YR2/2			
13-16"+	LS	10YR5/2 w/7.5YR5/6 mottling			
		mottling @ 13"			

**IDENTIFY LOCATIONS OF: (BORINGS, NEIGHBORING STRUCTURES, WELLS, DRAINFIELDS, DRAINAGE PATTERNS, OR OTHER FEATURES THAT MAY IMPACT THE SITE).**

**Install an 1860 Combination Tank  
for a Temporary Outhouse  
(will eventually be used for future Septic System)**

**DAVID SANNES  
Parcel# 19-0-046901  
SEPTIC DESIGN  
4/20/2009**

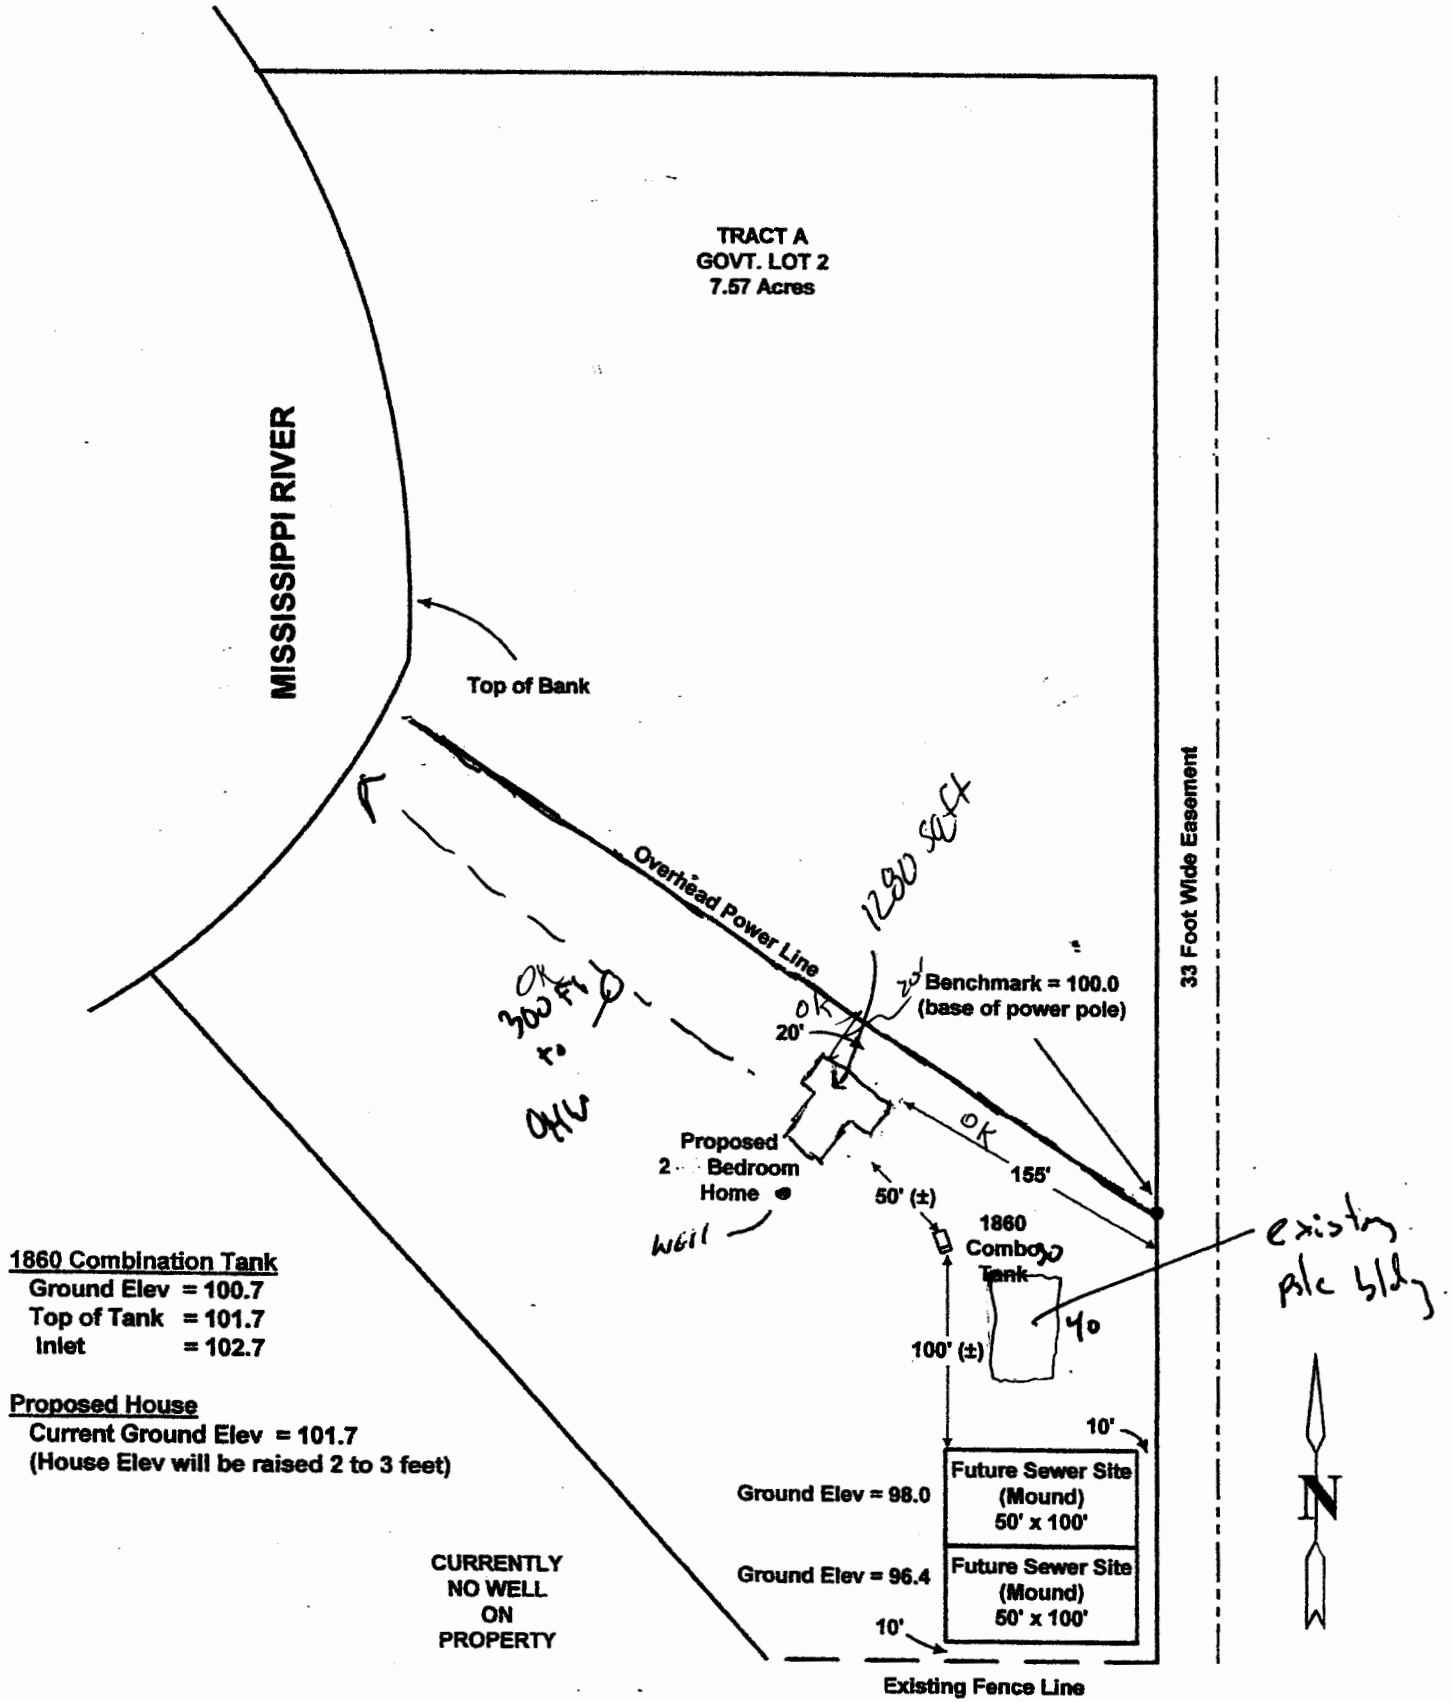

**1860 Combination Tank**  
Ground Elev = 100.7  
Top of Tank = 101.7  
Inlet = 102.7

**Proposed House**  
Current Ground Elev = 101.7  
(House Elev will be raised 2 to 3 feet)

**CURRENTLY  
NO WELL  
ON  
PROPERTY**

*existing  
alc bldg*



**Scale: 1" = 100'**