

Site Suitability Soil Boring Logs for Proposed Septic System Sites

Property Owner: Miles

Date: 5-17-13

- *Record depths of all horizons.
- *Record all Redoximorphic Features, Restricting Layers and Saturated Soils.
- *Include all Chroma and Hue values in boring log.

#1 Proposed Site 1

Depth in Inches	Texture	Munsell Color
0-6	Sandy loam	10YR 7/3
6-10	clay loam	10YR 4/3
10-22	sandy loam	10YR 7/4
22"	mottling	

#2 Proposed Site 2

Depth in Inches	Texture	Munsell Color
Same as #1		

#1 Alternate Site 3

Depth in Inches	Texture	Munsell Color
Same as #1		

#2 Alternate Site 4

Depth in Inches	Texture	Munsell Color
0-6	Sandy loam	10YR 7/3
6-12	Sandy loam	10YR 5/3
12-18	Sandy loam	10YR 7/4

Legal Description: _____



Parcel Number: 24-0-058400 Tract B

Designer Signature: Sue Ann Moschley Date: 5-17-13

S 89°52'11" E 1711.57'

Continuation of the Survey of the Section 16, Township 25 N, Range 102 W, T15N R102W

E

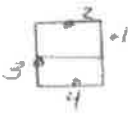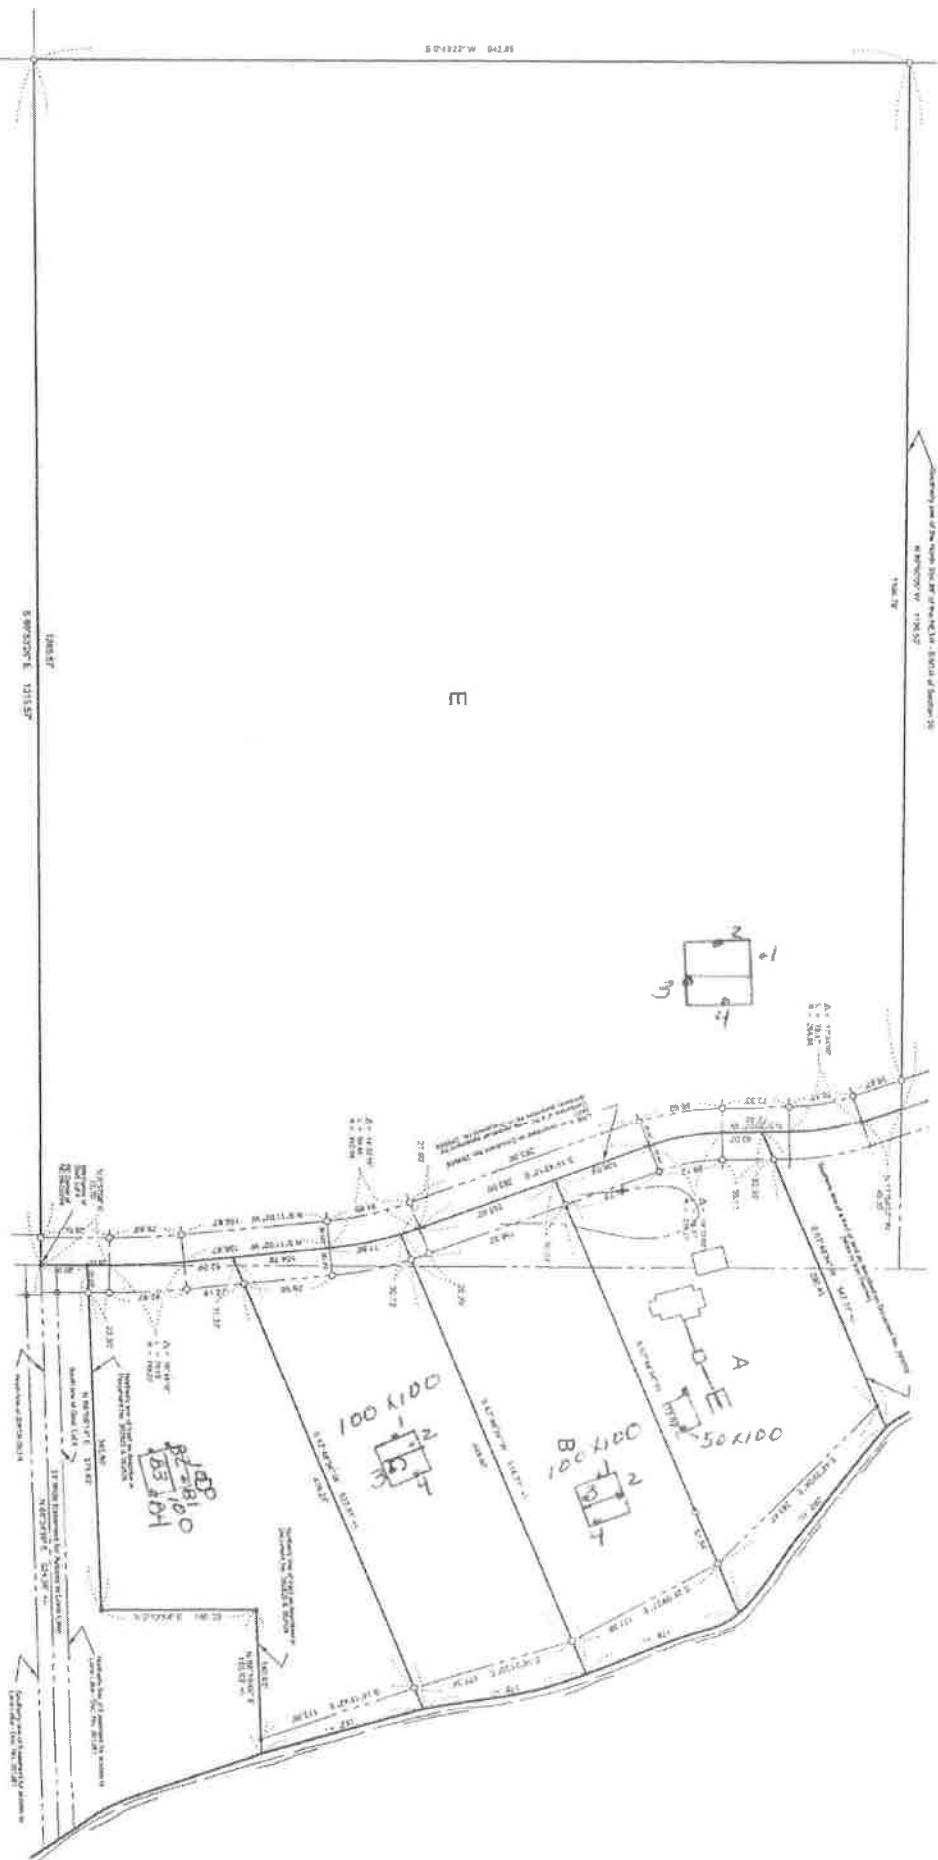

A - Contour
 B - 20' Contour
 C - 30' Contour

100100
 100100
 50100

